

GRENADE MISSISSIPPI BOARD OF WATER COMMISSIONERS

**CODED**

*W.H.A.*

F 12  
9-61

WATER WELL DRILLERS LOG


Date: Sept, 1961, Driller: Robert E. Rall, Jr County: Grenada  
(Name)

(1) Owner of Land: <u>Ward Deloach</u> (Name)	Description & Color of Materials Sand, Clay, Red Clay, Shell, etc.	Thick- ness Feet	Depth Feet
<u>Holcomb, Miss</u> (Address) <u>1922 03</u>	<u>Red Sand</u>	<u>0</u>	<u>50</u>
(2) Location: <u>1</u> miles <u>WEST</u> of <u>Holcomb</u> (distance) (direction) (Nearest Town)	<u>Shale rocks</u>	<u>50</u>	<u>210</u>
(3) Topography: <input checked="" type="checkbox"/> (Hilly) <input type="checkbox"/> (Flat) <input type="checkbox"/> (Level)	<u>Green Sand</u>	<u>210</u>	<u>250</u>
(4) Purpose of Well: <u>domestic</u> (Domestic Irrigation Municipal, Industrial, Other)	<u>Shale &amp; Gumbo</u>	<u>250</u>	<u>460</u>
	<u>White Sand</u>	<u>460</u>	<u>510</u>

**CODED**

Information upon completion of well:

- (1) Diameter 2x4 inches.
- (2) Total Depth 510 feet.
- (3) Water Level 90 feet below top of ground.  
166' 4"
- (4) Cased to depth, Size 2"
- (5) Screen: Size 2", Length 10'
- (6) Were any formations sealed against pollution?  
\_\_\_\_\_ yes, \_\_\_\_\_ no.

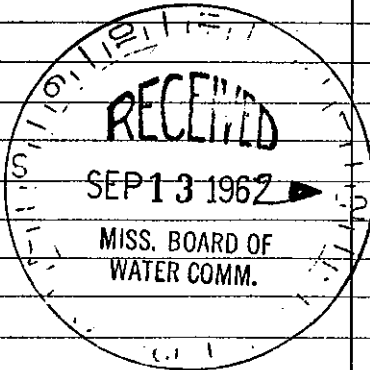

If YES depth of formation \_\_\_\_\_

Why \_\_\_\_\_

Drillers Remarks: well pumped  
10 GPM

Well No.

(Use Back Side)

Mail this copy to Board of Water Commissioners 429 Miss. St. Jackson, Miss