

GRENADA

MISSISSIPPI BOARD OF WATER COMMISSIONERS

F13

1-62

WATER WELL DRILLERS LOG

CODED

Date: Jan, 1962, Driller: Robert E. Rattiff, County: Grenada

(Name)

(1) Owner of Land: James Huffner  
 (Name)  
Halecamp, Miss.  
 (Address)

(2) Location: 22 3 S 3 E  
 (distance) (direction) (Nearest Town)

(3) Topography: \_\_\_\_\_  
 (Hilly) (Flat) (Level)

(4) Purpose of Well: Domestic  
 (Domestic Irrigation  
 Municipal, Industrial, Other)

Description & Color of Materials Sand, Clay, Red Clay, Shell, etc.	Thick- ness Feet	Depth Feet
0 - 24 red clay		
24 - 48 clay		
48 - 95 clay sand streaks		
95 - 155 sand		
155 - 219 rock shale		
219 - 230 sand		
230 - 279 rock sandy shale		
279 - 285 sand		
285 - 307 shale rock		
307 - 331 sand		
331 - 375 shale sand streaks		
375 - 419 shale		
419 - 463 hard shale		
463 - 504 hard shale sand streaks		
504 - 507 sand		
507 - 529 shale sand streaks		
529 - 559 sand		
559 - 570 sand course		

Information upon completion of well:

(1) Diameter 2 1/4 inches.

(2) Total Depth 570 feet.


(3) Water Level 129 feet below top of ground.

(4) Cased to 570, Size 2 1/4

(5) Screen: Size 2", Length 10'

(6) Were any formations sealed against pollution?  
 \_\_\_\_\_ yes, \_\_\_\_\_ no.

CODED

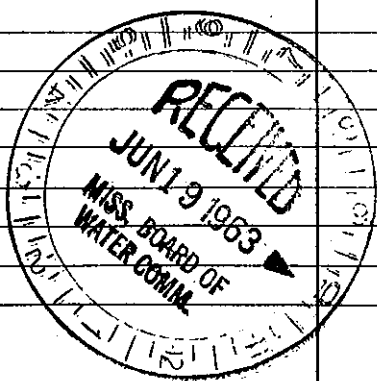

(Use Back Side)

Well No.

Retain this copy for your office files.