

GRENADA MISSISSIPPI BOARD OF WATER COMMISSIONERS

F 14

3-6-62 *off 11/11* WATER WELL LOG

CODED

Date: 3-6, 1962, Driller: Robert E. Rattuff County Grenada
(Name)

(1) Owner of Land: Mr. Luther Harris
(Name)
Halecomb Miss.
(Address)

(2) Location: 1/4, 1/4, Sec. 16 22 3
(distance) (direction) (Nearest Town)

(3) Topography: Flat
(Hilly) (Flat) (Level)

(4) Purpose of Well: Domestic
(Domestic Irrigation Municipal, Industrial, Other)

Description & Color of Materials Sand, Clay, Red Clay, Shell, etc.	Thick- ness Feet	Dept. Feet
clay	15'	15'
sand	11'	26'
gravel	1'	27'
shale	26'	53'
rock	1'	54'
shale	8'	62'
rock	1'	63'
shale	24'	87'
rock	4'	91'
sand	6'	97'
rock	1'	98'
shale	16'	114'
rock	34'	150'
sand	5'	155'
shale	17'	172'
sand	1'	173'
shale	14'	187'
sand	8'	205'
shale	30'	235'
sand	20'	255'
shale	65'	320'
sand	8'	328'
shale	17'	345'
sand	10'	355'
shale	5'	360'
sand	4.7'	40.7'

Information upon completion of well:

(1) Diameter 2 inches.

(2) Total Depth 407 feet.

(3) Water Level Flowing feet below top of ground.

(4) Cased to 397', Size 2"


(5) Screen: Size 2", Length 10'

(6) Were any formations sealed against pollution?
 yes, no.

If YES depth of formation Casert 10'

Why _____

Drillers Remarks: _____

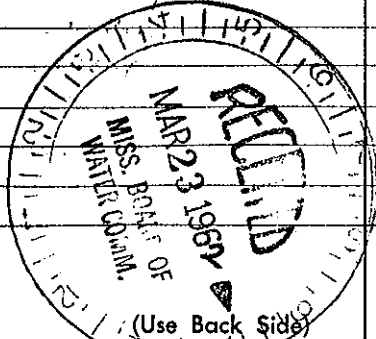

Well No.

Mail this copy to Board of Water Commissioners 429 Miss. St. Jackson, Miss