

GRENADA

MISSISSIPPI BOARD OF WATER COMMISSIONERS

F 21

4-1-64

WATER WELL DRILLERS LOG


CODED

Date: April 1, 1964, Driller: Robert E. Ratliff County Grenada

(Name)

(1) Owner of Land:	Description & Color of Materials Sand, Clay, Red Clay, Shell, etc.	Thick- ness Feet	Depth Feet
<u>Oscar Staten</u> (Name)	<u>red clay-gravel</u>	<u>24</u>	<u>24</u>
<u>7 Salcomb, Miss</u> (Address)	<u>clay</u>	<u>24</u>	<u>48</u>
<u>6 22 3</u>	<u>clay sand streaks</u>	<u>23</u>	<u>71</u>
(2) Location: <u>1/4, 1/4, Sec. T R</u>	<u>clay sand streaks</u>	<u>24</u>	<u>95</u>
<u>3</u> miles <u>east</u> of <u>Ophery</u>	<u>shale</u>	<u>24</u>	<u>119</u>
(distance) (direction) (Nearest Town)	<u>sand</u>	<u>36</u>	<u>155</u>
(3) Topography: <u>Hilly</u>	<u>shale + rock</u>	<u>53</u>	<u>210</u>
(Hilly) (Flat) (Level)	<u>sand + shale</u>	<u>9</u>	<u>219</u>
(4) Purpose of Well: <u>domestic</u>	<u>sand</u>	<u>11</u>	<u>230</u>
(Domestic Irrigation Municipal, Industrial, Other)	<u>rocks + shale</u>	<u>11</u>	<u>241</u>
Information upon completion of well:	<u>rock + sandy shale</u>	<u>38</u>	<u>279</u>
(1) Diameter <u>4</u> inches.	<u>sand</u>	<u>6</u>	<u>285</u>
(2) Total Depth <u>693</u> feet.	<u>shale</u>	<u>22</u>	<u>307</u>
(3) Water Level <u>175</u> feet below top of ground.	<u>sand</u>	<u>24</u>	<u>331</u>
(4) Cased to <u>693'</u> , Size <u>4" x 2"</u>	<u>shale</u>	<u>88</u>	<u>419</u>
(5) Screen: Size <u>2"</u> , Length <u>10'</u>	<u>hard shale + sand streak</u>	<u>85</u>	<u>504</u>
(6) Were any formations sealed against pollution?	<u>sand</u>	<u>3</u>	<u>507</u>
<input checked="" type="checkbox"/> yes, <input type="checkbox"/> no.	<u>shale</u>	<u>92</u>	<u>600</u>
If YES depth of formation _____	<u>shale + sand streak</u>	<u>40</u>	<u>640</u>
Why <u>4" x 6' x 6' concrete slab</u>	<u>shale</u>	<u>30</u>	<u>670</u>
Drillers Remarks: _____	<u>sand</u>	<u>23</u>	<u>693</u>

CODED

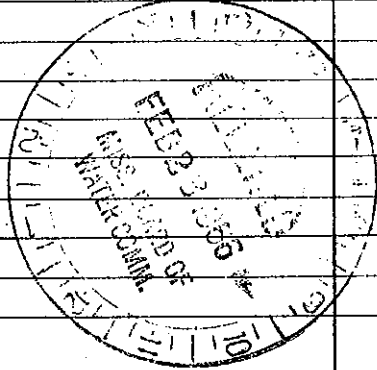

(Use Back Side)

Well No.

Mail this copy to Board of Water Commissioners 429 Miss. St. Jackson, Miss