

GRENA DA MISSISSIPPI BOARD OF WATER COMMISSIONERS

F 22


5-25-64

WATER WELL DRILLERS LOG

CODED

Date: May 25, 1964, Driller: Robert F. Ratliff County: Grenada
(Name)

(1) Owner of Land: <u>Beathley Church</u> <small>(Name)</small>	Description & Color of Materials Sand, Clay, Red Clay, Shell, etc.	Thick- ness Feet	Depth Feet
<u>Holcomb, Miss</u> <small>(Address)</small>	<u>Red clay</u>	<u>0</u>	<u>0</u>
(2) Location: <u>1/4</u> , <u>1/4</u> , Sec. <u>4 22 3</u> <small>(distance) (direction) (Nearest Town)</small>	<u>land</u>	<u>22</u>	<u>66</u>
(3) Topography: <u>Hilly</u> <small>(Hilly) (flat) (Level)</small>	<u>land - Red shale</u>	<u>66</u>	<u>88</u>
(4) Purpose of Well: <u>Domestic</u> <small>(Domestic Irrigation Municipal, Industrial, Other)</small>	<u>shale, Red</u>	<u>88</u>	<u>109</u>
Information upon completion of well:	<u>shale + Red</u>	<u>109</u>	<u>153</u>
(1) Diameter <u>4 1/2</u> inches.	<u>shale</u>	<u>153</u>	<u>200</u>
(2) Total Depth <u>538</u> feet.	<u>shale + land streak</u>	<u>200</u>	<u>231</u>
(3) Water Level <u>55</u> feet below top of ground.	<u>land</u>	<u>231</u>	<u>241</u>
(4) Cased to <u>538</u> Size <u>4"</u>	<u>land + sandy shale</u>	<u>241</u>	<u>263</u>
(5) Screen: Size <u>3"</u> , Length <u>5'</u>	<u>land + sandy shale</u>	<u>263</u>	<u>285</u>
(6) Were any formations sealed against pollution? <input checked="" type="checkbox"/> yes, <input type="checkbox"/> no.	<u>land + sandy shale</u>	<u>285</u>	<u>307</u>
If YES depth of formation <u>Cased</u>	<u>Hard shale</u>	<u>307</u>	<u>309</u>
Why _____	<u>land</u>	<u>309</u>	<u>348</u>
Drillers Remarks: _____	<u>shale</u>	<u>348</u>	<u>351</u>
_____	<u>shale 7" Red</u>	<u>351</u>	<u>372</u>
_____	<u>shale + sandy streak</u>	<u>372</u>	<u>394</u>
_____	<u>shale + land streak</u>	<u>394</u>	<u>416</u>
_____	<u>shale</u>	<u>416</u>	<u>428</u>
_____	<u>land</u>	<u>428</u>	<u>452</u>
_____	<u>land + shale</u>	<u>452</u>	<u>493</u>
_____	<u>fine sand</u>	<u>493</u>	<u>503</u>
_____	<u>land</u>	<u>503</u>	<u>525</u>
_____	<u>land</u>	<u>525</u>	<u>538</u>

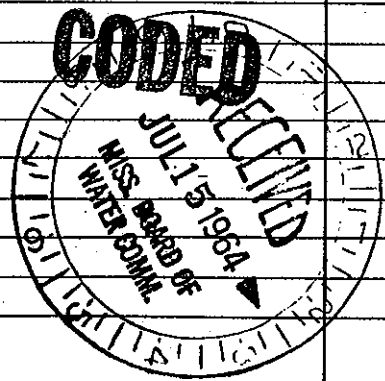

(Use Back Side)

Well No.

Mail this copy to Board of Water Commissioners 429 Miss. St. Jackson, Miss.