

GRENADA MISSISSIPPI BOARD OF WATER COMMISSIONERS

F23
12-2-65

WATER WELL DRILLERS LOG

CODED

12/9/65
2102

Date: Dec. 2, 1965, Driller: Layne-Central Company County Leflore

(Name)

(1) Owner of Land: and Gravel Company
J.J. Ferguson Sand
(Name)
Greenwood, Mississippi
(Address)

(2) Location: 9 2 1 3 1/4, 1/4, Sec. 1 T. R.
6 miles south of Holcomb
(distance) (direction) (Nearest Town)

(3) Topography: flat
(Hilly) (Flat) (Level)

(4) Purpose of Well: gravel wash water
(Domestic Irrigation
Municipal, Industrial, Other)

Description & Color of Materials Sand, Clay, Red Clay, Shell, etc.	Thick- ness Feet	Depth Feet
Gravel	58	58
White clay balls, sand	118	176
Blue clay	39	215
Rock	1	216
Shale sandy	4	220
Rock	2	222
Sandy shale	6	228
Rock	6	234
Sandy shale	66	300
Rock	1	301
Sandy shale	85	386
Hard clay, blue	34	420
Sandy shale	32	452
Sand, white	30	482
Hard pink clay		482

Information upon completion of well:

(1) Diameter 8x12 inches.

(2) Total Depth 588 feet.

(3) Water Level 175' feet below top of ground.
61' 8"

(4) Cased to 547' Size 12"
5' lap


(5) Screen: Size 12", Length 30'

(6) Were any formations sealed against pollution?
yes yes, no no.

If YES depth of formation Cement plug
around bottom of upper casing and
B.P.V.
Why

Drillers Remarks:

CODED

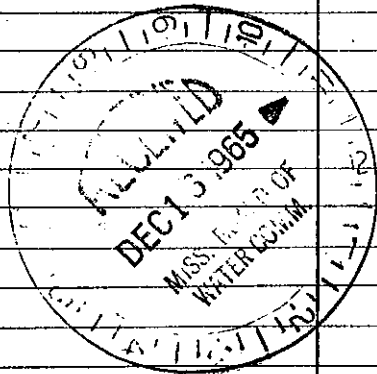

Well No.

(Use Back Side)

Mail this copy to Board of Water Commissioners 429 Miss. St. Jackson, Miss