Grenada		ell Report	For Office Use Only:		
County: Grenada		Part 1 Mississippi Department of Environmental Quality			
Permit#: Irrigation Equipment	Office of Land and Water Resources		Well #: <b>F-</b> //8		
Driller:	P.O. Box 10631 Jackson, MS 39289-0631		L. S. Elevation:		
Date drilling completed: $11 - 20 - 06$	(601)961-5210		E-log #:		
· · · · · · · · · · · · · · · · · · ·	[ (601)35	4-6938 (fax)	E-log #:		
State Law requires that this rep 30 days of completion of drilling					
Well Owner Informa	tion	33 45' 19	Location 1N 90 00' 29.6W		
Owner Name_ Little & Litt	le	Latitude:'	" Longitude:		
Mailing Address: 11268 Hwy.8	3	Method of Lat/Long (circle or	ne): Conventional Survey,		
¢		USGS quad, Hand-held GPS, Survey-grade GPS			
	20040	NE 1/4 SW 1/4 Sec 20	Twn 22N Rng 3E		
Holcomb, MS 38940   City State Zip Code Distance Direction					
662-417-6548 Telephone No. ()	3		of Holcomb		
Well Data					
Purpose of Well (circle one) Home Ind		$\sim$	Other.		
Date well drilling started: $11-2($		vell drilling completed:1			
If flowing, method of flow regulation: Valve Other (describe)					
Static Water Level: feet above or below (circle one) land surface Date measured:					
Method of Measurement (circle one) steel tape electric tape air line other:					
Hole depth: <u>86</u> Well dep	pth: 86	Well grouted to a depth of _	<u>10</u> feet		
Type of grout (circle one): Cement	Bentonite Mix				
Casing length: 76 feet Casin	ng diameter. 16	inches Type of casing: _	PVC Sch.40		
Screen length: <u>10</u> feet Scre	en diameter: <u>16</u>	inches Type of screen:	PVC Sch.40		
Screen slot size:	Setting depth: From _	23 feet to	32 feet		
Type of completion (circle all applicable):	Gravel packed Under	reamed Telescoped Open	hole Natural Development		
	Other (describe):				
Top of lap pipe or reduction in casing:	feet. If te	lescoped or more than one scr	een, describe on back of page		
Logs run (circle all applicable): No log ru	g) Electric Gamma Ray	Density Sonic Neutron	Other:		
Name of organization running log(s): I certify that the well was drilled, constr	matad and an -1 - 1 -		manipum and the Miniat		
Department of Environmental Quality a	-				
Irrigation Equipm Patrick M. Chism		P. / /	mch		
Print Name of Water Well Contractor and			Water Well Contractor		
	- replaced 1				

.

BV: OLVE


If well telescopes please sketch below and show depths.

## Ground Level

5

Description of Formations Encountered	From	То
	0	26
Clay Med. Sand/gravel Fine Sand/clay	27	3.2
Fine Sand/clay	33	86
· ·		
		+
		-

If more than one screen, show location of each on sketch

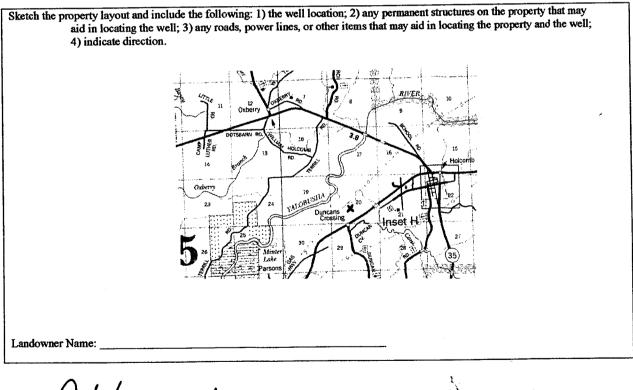

Signature of Water Well Contractor