
State W	ell Report			
	Driller's Log	For Office Use Only:		
Mississippi Departmen	t of Environmental Quality	Aquifer:		
	nd Water Resources	Well #: FOI21_		
Driller: MS. OFFICE OF GEOLUGY I	Box 10631 IS 39289-0631	L. S. Elevation:		
	961-5210			
(601)35	4-6938 (fax)	E-log #: F-0121		
State Law requires that this report be prepared by the lice Department at the above address within 30 days of comp				
Information on Well Owner		rehole Location		
(Landowner if borehole is not for a water well)	Latitude: 33 • 40 , 46 " Longitude: 90 00, 47,			
Dwner Name Rebecca Hobgood	Latitude: 33 ° 40 ' 40	" Longitude: 10 <sup>d</sup> 00 ' 11 "		
Mailing Address: 4986 County Rd. #105	Method of Lat/Long (circle one): Convention			
1	USGS quad Hand-held	GPS, Survey-grade GPS		
Holcomb, MS 38940 City State Zip Code	<u>SW 1/4 SW 1/4 Sec 17</u>			
	Distance Direction Miles			
relephone No. (662 453 - 00 95	Milles	DI		
Well / Bore	hole Data	·····		
Date drilling started: $\frac{4/14/10}{16/16}$ Date drilling completed: $\frac{4/16/16}{16}$	Hole depth: 5300	Hole diameter:		
location of the source of any surface water used for drilling:	opment: 1 cal Chlorine,	Sleach 1000 colta		
Logs run (circle all applicable): No log ron Electric Gamma Ray Name of organization running log(s): In S Geolog Y	•			
Purpose of borehole (check one): Water Well Geotechnical/Geolo	ogical Investigation X Ground	Source Heat Pump		
Seismic Survey Other ( <i>describe</i> ) If drilling is not related to water well construction		ck		
urpose of Well (check one): Home Industrial Public Supply	Irrigation Fish Culture _	Other:		
If a flowing well, method of flow regulation: Valve Other (describe)				
Static Water Level:feet above or below (circle one) land surface Date measured:				
Method of Measurement (circle one) steel tape electric tape air line other:				
Well depth: Well grouted to a depth offeet Type of grout (circle one): Neat Cement Bentonite Mix				
asing length:feet Casing diameter:	_inches Type of casing:			
creen length:feet Screen diameter:	inches Type of screen:			
creen slot size:inches Setting depth: From	feet to	feet		
ype of completion (circle all applicable): Gravel packed Underr	eamed Telescoped Open l	nole Natural Development		
Other (describe):				
op of lap pipe or reduction in casing:feet. If tele	escoped or more than one scree	n, describe on next page		

MAY 0 7 2010



## The sketch below only required for water wells

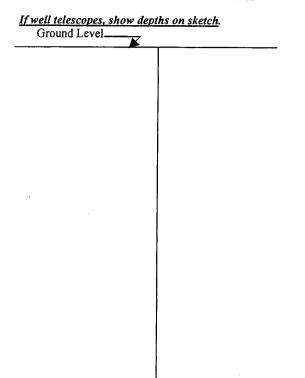

## Description of formations encountered must be provided for all wells and boreholes, unless specifically exempted by regulations

Description of Formations Encountered	From (depth)	To (depth)
	Ground Level	
Clay	0	19
Gravel yellow,	19	37
(ay (white brange)	37	105
Sand	105	145
purple clay	195	157
Sand	157	218
clay,	218	262
Salty clay	262	300
(AGE and)		
(Kech of 295')		
	·	
-		

If more than one screen, show location of each on sketch

<ul> <li>Sketch the property layout and include the following: 1) the well location; 2) any permanent structures on the aid in locating the well; 3) any roads, power lines, or other items that may aid in locating the pro-4) a north arrow.</li> </ul>	property that may property and the well;
- - -	
Landowner Name:	

Form: OLWR-SWR-1A

I certify that the well/borehole was drilled, constructed, and completed in accordance with all applicable requirements of the Mississippi Department of Environmental Quality and the Mississippi Department of Health regulations, if applicable, and state laws.

ARCHIE MCKENZIE 0-555

Date

5/10 Al- Mal

Print Name of Responsible Licensee and License No.

Signature of Licensee