

G

WATER WELL DRILLERS LOG


off w/h

8-18-62

Date: Aug 18, 1962, Driller: Robert E Roth, Jr County Grenada

(Name)

(1) Owner of Land: <u>H.M. Blair</u> (Name)	Description & Color of Materials Sand, Clay, Red Clay, Shell, etc.	Thick- ness Feet	Depth Feet
<u>Grenada, Miss</u> (Address)	<u>Red Clay-sand</u>	<u>0</u>	<u>23</u>
(2) Location: <u>1/4</u> , <u>1/4</u> , Sec. <u> </u> , T. <u> </u> , R. <u> </u>	<u>rock-shale streak</u>	<u>23</u>	<u>43</u>
<u>6</u> miles <u>west</u> of <u>Grenada</u> (distance) (direction) (Nearest Town)	<u>shale-rocks</u>	<u>43</u>	<u>65</u>
(3) Topography: <input checked="" type="checkbox"/> (Hilly) <input type="checkbox"/> (Flat) <input type="checkbox"/> (Level)	<u>shale-rocks</u>	<u>65</u>	<u>131</u>
(4) Purpose of Well: <u>domestic</u> (Domestic Irrigation, Municipal, Industrial, Other)	<u>sandy shale</u>	<u>131</u>	<u>196</u>
Information upon completion of well:	<u>shale, rocks, sand streak</u>	<u>196</u>	<u>218</u>
(1) Diameter <u>4</u> inches.	<u>shale</u>	<u>218</u>	<u>228</u>
(2) Total Depth <u>333</u> feet.	<u>rocks</u>	<u>228</u>	<u>230</u>
(3) Water Level <u>93</u> feet below top of ground.	<u>shale, rock, sand streak</u>	<u>230</u>	<u>240</u>
(4) Cased to depth, Size <u>4"</u>	<u>shale, sand streaks</u>	<u>240</u>	<u>283</u>
(5) Screen: Size <u>4"</u> , Length <u>20'</u>	<u>shale, sand</u>	<u>283</u>	<u>305</u>
(6) Were any formations sealed against pollution? <u> </u> yes, <u> </u> no.	<u>good sand</u>	<u>305</u>	<u>337</u>

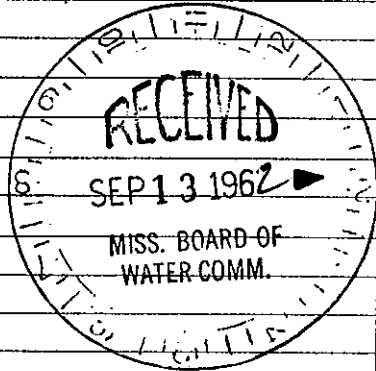

If YES depth of formation _____

Why _____

Drillers Remarks: well pumped 189PM

(Use Back Side)

Well No.