


CASE

Grenada
G 2
11/67
Elec 609

MISSISSIPPI
BOARD OF WATER COMMISSIONERS
416 North State Street
Jackson, Mississippi 39201

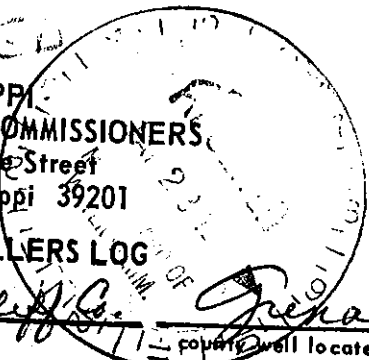

WATER WELL DRILLERS LOG

11-14-67 19 Robert E. Raloff Co. Grenada
date well completed firm name county well located

LANDOWNER: Holiday
Inn & America
Grenada Miss.
(mailing address)

WELL LOCATION:
sec 12 T 22 R 4
S W
2 miles West of Grenada
(distance) (direction) (nearest town)

WELL PURPOSE: Industrial
(home, irrigation, municipal, industrial)

WELL COMPLETION DATA:
(1) diameter (inches) 6"
(2) total depth (feet) 1142-hole
(3) static water level (feet) _____ below above top of ground.
(4) casing B. steel 602'
(material) (depth)
6"
(size) If telescope see back.
(5) screen 60 602'
(length) (depth to top)
4" S.S.
(size) (material)
(6) pump 10 90
(HP) (yield gpm)
electric
(type power)
(7) electric log yes (USGS E-log # 43)
(yes or no)
No. Geo. Survey
(organization running log)
(8) how well bottom plugged B.P.V.

description of formations encountered	from to	
Red clay + sand	0	24
sand, shale streaks	24	46
sandy shale	46	69
sandy shale	69	183
sand	183	194
shale	194	206
shale + sand streaks	206	227
shale	227	251
sand	251	313
shale	313	315
sandy shale	315	337
shale, sand rock	337	359
sandy shale	359	380
sandy shale	380	488
shale rocks	488	510
shale	510	590
sand - good	590	631
shale	631	638
sand	638	640
shale	640	649
sand	649	659
shale	659	662
shale + sand streaks	662	684
shale, rock	684	721
rock	721	725
shale	725	728
shale, rock	728	749
shale	749	837
sand	837	847
shale	847	889
sand	889	920
shale	920	923
sand + shale	923	945
shale sand streaks	945	967
sand	967	968
shale, rock, sand streaks	968	989
sandy shale, rock at base	989	1020
sand	1020	1032
shale, rock at base	1032	1142
and 1067		

DRILLERS REMARKS: