

Grenada  
G 8  
10-66


MISSISSIPPI BOARD OF WATER COMMISSIONERS

WATER WELL DRILLERS LOG

coded

Date: 10-14, 1966, Driller: Butane Gas Co. County: Grenada  
(Name)

(1) Owner of Land:	Description & Color of Materials Sand, Clay, Red Clay, Shell, etc.	Thick- ness Feet	Depth Feet
Clarence Flowers (Name) Holtcomb, Miss. (Address)	Clay	30	30
(2) Location: SW 1/4, SW 1/4, Sec. 8 T21 N 44 E, 5 miles E of Holtcomb (distance) (direction) (Nearest Town)	Red Sand	20	50
(3) Topography: X (Hilly) (Flat) (Level)	Shale	60	110
(4) Purpose of Well: Domestic (Domestic Irrigation Municipal, Industrial, Other)	Brown Sand	36	146
Information upon completion of well:			
(1) Diameter 4 3/4 inches.			
(2) Total Depth 146 feet.			
(3) Water Level 35' feet below top of ground.			
(4) Cased to 145, Size 2"			
(5) Screen: Size 2", Length 10'			
(6) Were any formations sealed against pollution?			
yes, X no.			
If YES depth of formation			
Why			
Drillers Remarks:			

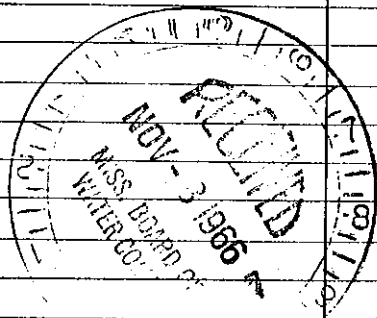

Well No.

(Use Back Side)

Retain this copy for your office files.