

Grenada  
G 10  
1-67

MISSISSIPPI  
BOARD OF WATER COMMISSIONERS  
416 North State Street  
Jackson, Mississippi 39201

Coded

WATER WELL DRILLERS LOG

1-25-67 date well completed  
Forest Drilling Co. firm name  
Grenada county well located

LANDOWNER: Humble Oil  
P.O. Grenada, Miss  
Box 5044  
Jackson, Miss  
(mailing address)

WELL LOCATION: Don't have this  
sec. 12-22 R. 4 S. 34  
2 mi miles west of Grenada  
(distance) (direction) (nearest town)

WELL PURPOSE: Service Station  
(home, irrigation, municipal, industrial)

description of formations encountered	from	to
<u>Red Clay &amp; Sand</u>	<u>0</u>	<u>25</u>
<u>Clay + S. Sta. Sand</u>	<u>25</u>	<u>163</u>
<u>Clay + S. Sta. Sand</u>	<u>163</u>	<u>206</u>
<u>Sand + S. Sta. Clay</u>	<u>206</u>	<u>226</u>
<u>Good Sand</u>	<u>226</u>	<u>252</u>

WELL COMPLETION DATA:

(1) diameter (inches) 4" x 2"

(2) total depth (feet) 252

(3) static water level (feet) 63 below top of ground.

(4) casing 2" galv. 50ft  
2" galv. 180ft  
4" top pipe -  
(material) (depth)  
(size) if telescope see back.


(5) screen 20ft, 232  
(length) (depth to top)  
2"  
(size) 4m Brass  
(material)

(6) pump 3 hp  
(HP) (yield gpm) 40-50  
270 - 1 ph. electric  
(type power)

(7) electric log No  
(yes or no)

(organization running log)

(8) how well bottom plugged 2"  
backfill with sand

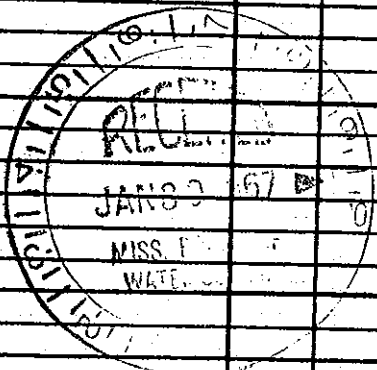

DRILLERS REMARKS: