

GRENADA

MISSISSIPPI BOARD OF WATER COMMISSIONERS

G13

Correct from  
top records  
172171

4-3-65

WATER WELL DRILLER

**CODED**

Date: April 3, 1965, Driller: Robert E. Rattiff County Grenada  
(Name)

(1) Owner of Land: Mr. John Bayd  
Grenada Miss.  
(Name)  
(Address)

(2) Location:  $\frac{1}{4}$ ,  $\frac{1}{4}$ , Sec. 36 22 4 R.  
5 miles S. west of Grenada  
(distance) (direction) (Nearest Town)

(3) Topography: Hilly  
(Hilly) (Flat) (Level)

(4) Purpose of Well: Domestic  
(Domestic Irrigation  
Municipal, Industrial, Other)

Description & Color of Materials Sand, Clay, Red Clay, Shell, etc.	Thick- ness Feet	Depth Feet
<u>Tap Soil</u>	<u>33</u>	<u>33</u>
<u>Sand</u>	<u>.5</u>	<u>34</u>
<u>Shale</u>	<u>22</u>	<u>60</u>
<u>white sand</u>	<u>13</u>	<u>73</u>
<u>Shale</u>	<u>127</u>	<u>200</u>
<u>Green sand</u>	<u>33</u>	<u>233</u>
<u>Hard shale</u>	<u>57</u>	<u>290</u>
<u>white sand</u>	<u>63</u>	<u>353</u>

Information upon completion of well:


- (1) Diameter 4 inches.
- (2) Total Depth 353 feet.
- (3) Water Level 88 feet below top of ground.
- (4) Cased to 343, Size 4x2"
- (5) Screen: Size 2, Length 10
- (6) Were any formations sealed against pollution?  
4" x 6' x 6' concrete slab  
yes, no.

If YES depth of formation \_\_\_\_\_

Why \_\_\_\_\_

Drillers Remarks: 10' 2" Johnson  
Stainless steel screen no 8  
well pumped 50 G.P.M.

**CODED**

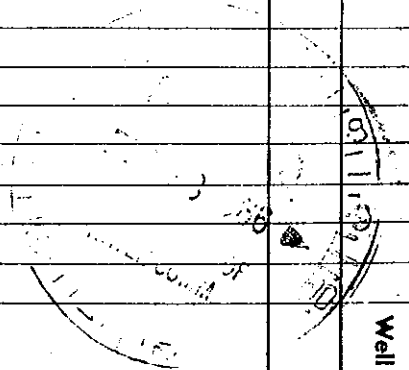

(Use Back Side)

Well No.

Mail this copy to Board of Water Commissioners 429 Miss. St. Jackson, Miss.