

GRENADA
 GOIS
 6-62

MISSISSIPPI BOARD OF WATER COMMISSIONERS

WATER WELL DRILLERS **CODED**

Date: June, 1962, Driller: Robert E. Rathoff County Grenada
 (Name)

(1) Owner of Land: J. J. Hamby
 (Name)
R-H Grenada, Miss
 (Address)

(2) Location: 1/4, 1/4, Sec. 36 22 9
 (distance) (direction) (Nearest Town)

(3) Topography: (Hilly) (Flat) (Level)

(4) Purpose of Well: _____
 (Domestic Irrigation
 Municipal, Industrial, Other)

Description & Color of Materials Sand, Clay, Red Clay, Shell, etc.	Thick- ness Feet	Depth Feet
Buckshot sand	0	22
Sand shale	22	44
Sand + shale streaks	44	66
shale	66	82
Sand	82	154
Sand - shale	154	176
shale	176	220
shale - sand streaks	220	242
shale	242	285
shale sand streaks	285	307
shale	307	410
Rock	410	410
shale	413	452
Sand	452	470

Information upon completion of well:

(1) Diameter 2 1/4 inches.

(2) Total Depth 470' feet.


(3) Water Level Flowing feet below top of ground.

(4) Cased to 470, Size 2 1/2 of 4"
2 1/2 of 2"

(5) Screen: Size 2, Length 10.

(6) Were any formations sealed against pollution?
 _____ yes, no.

CODED

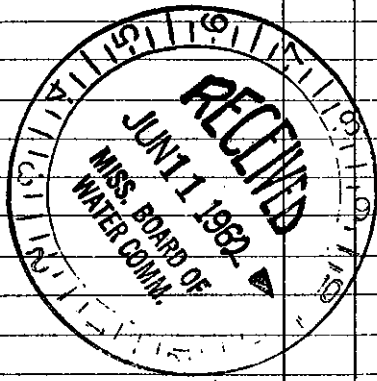

If YES depth of formation _____

Why _____

Drillers Remarks: _____

(Use Back Side)

Well No.

Mail this copy to Board of Water Commissioners 429 Miss. St. Jackson, Mis