

ATER COMMISSIONERS

GRAND

WATER WELL DRILLERS LOG

Date: 6-5-60 ²⁰⁰⁰ 1960, Driller: Luther Rathjff County Nevada
 (Name)

(1) Owner of Land: H. L. Lett
 (Name)
Holcomb, Miss
 (Address)
 (2) Location: 1/4, 1/4, Sec. 19 2 24
 (distance) (direction) (Nearest Town)
 (3) Topography: (Hilly) (Flat) (Level)
 (4) Purpose of Well: Domestic
 (Domestic Irrigation, Municipal, Industrial, Other)

Description & Color of Materials Sand, Clay, Red Clay, Shell, etc.	Thick- ness Feet	Depth Feet
<u>0-25 Clay</u>	<u>0</u>	<u>25</u>
<u>Clay + sand</u>	<u>25</u>	<u>47</u>
<u>Sand + gravel</u>	<u>47</u>	<u>69</u>
<u>Gravel</u>	<u>69</u>	<u>91</u>
<u>Gravel + shale</u>	<u>91</u>	<u>113</u>
<u>Shale + sand</u>	<u>113</u>	<u>135</u>
<u>Sand</u>	<u>135</u>	<u>157</u>
<u>Sand + gravel</u>	<u>157</u>	<u>179</u>
<u>Sand</u>	<u>179</u>	<u>191</u>


Information upon completion of well:

(1) Diameter 2" inches.
 (2) Total Depth 191 feet.
 (3) Water Level 144 feet below top of ground.
 (4) Cased to 191, Size 2"
 (5) Screen: Size 2" , Length 10'
 (6) Were any formations sealed against pollution?
 _____ yes, _____ no.

If YES depth of formation _____

Why _____

Drillers Remarks: _____

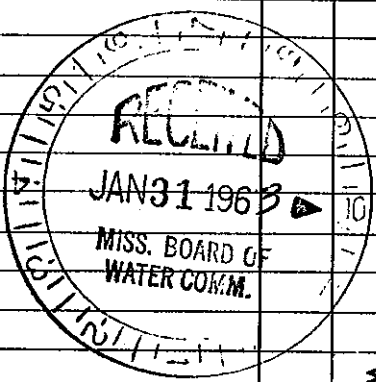

Well No.

(Use Back Side)

Mail this copy to Board of Water Commissioners 429 Miss. St. Jackson, Miss