

GRENADA MISSISSIPPI BOARD OF WATER COMMISSIONERS

~~W~~G 2001

2-63

WATER WELL DRILLERS LOG

Date: Feb. 1963, Driller: Robert E. Ratliff County Grenada
(Name)

(1) Owner of Land: (Name) Grenada, Miss. (Address)	Description & Color of Materials Sand, Clay, Red Clay, Shell, etc.	Thick- ness Feet	Depth Feet
	0-25 clay		
	25-35 sand		
	35-125 shale		
	125-135 sand		
	135-142 shale + sand		
	142-225 shale		
	225-245 sand		
	245-253 sand + shale		
	253-263 shale		
	263-310 sand		
	310-355 shale		
	355-365 sand		
	365-397 sand shale		
	397-397 sand		
	397-443 shale		
	443-447 sand		
	447-496 shale		
	496-514 sand		
	514-515 rock		
	515-617 sand		
	617-618 shale		


(2) Location: 1/4, 1/4, Sec. 7 224 T. R.
miles (distance) _____ of _____ (Nearest Town)
(direction) _____
(3) Topography: _____
(Hilly) (Flat) (Level)
(4) Purpose of Well: Domestic
(Domestic Irrigation, Municipal, Industrial, Other)

Information upon completion of well:

- (1) Diameter 3XH inches.
- (2) Total Depth 617 feet.
- (3) Water Level Flaming feet below top of ground.
- (4) Cased to 617, Size 3XH
- (5) Screen: Size 3, Length 20'
- (6) Were any formations sealed against pollution?
 yes, _____ no.

If YES depth of formation Cement
Why _____

Drillers Remarks: _____

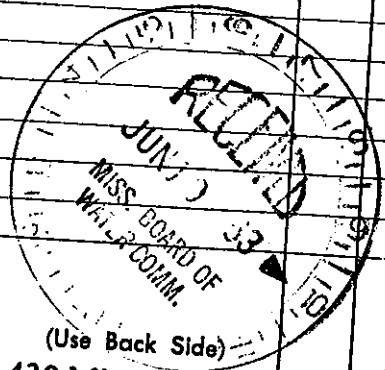

Well No. _____

Mail this copy to Board of Water Commissioners 429 Miss. St. Jackson, Miss.