

GRENADA MISSISSIPPI BOARD OF WATER COMMISSIONERS

H  
3-2-62

WATER WELL DRILLERS LOG

*W.H.L.*

Date: 3-2, 19 62 Driller: Robert E. Rattiff County Grenada  
(Name)

		Description & Color of Materials Sand, Clay, Red Clay, Shell, etc.	Thick- ness Feet	Depth Feet
(1) Owner of Land:	<u>Mr. J. Z. Poyor</u> (Name) <u>Grenada, Miss.</u> (Address)			
(2) Location:	<u>1/4</u> , <u>1/4</u> , Sec. <u>   </u> T. <u>   </u> R. <u>   </u> miles of <u>   </u> (distance) (direction) (Nearest Town)	<u>Clay</u> <u>Red Sand</u> <u>Shale</u> <u>white sand</u>	<u>15</u> <u>75</u> <u>115</u> <u>122</u>	<u>15</u> <u>100</u> <u>218</u> <u>224</u>
(3) Topography:	<u>Hilly</u> (Hilly) (Flat) (Level)			
(4) Purpose of Well:	<u>Domestic</u> (Domestic Irrigation Municipal, Industrial, Other)			


Information upon completion of well:

- (1) Diameter 2" inches.
- (2) Total Depth 236 feet.
- (3) Water Level 140 feet below top of ground.
- (4) Cased to 231, Size 2"
- (5) Screen: Size 2", Length 5'
- (6) Were any formations sealed against pollution?  
X yes,     no.

If YES depth of formation about 10'

Why    

Drillers Remarks:    

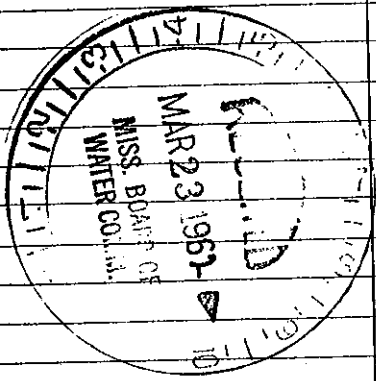

(Use Back Side)

Well No.    

Mail this copy to Board of Water Commissioners 429 Miss. St. Jackson, Miss.