

GRENADA MISSISSIPPI BOARD OF WATER COMMISSIONERS

H

No

WATER WELL DRILLERS LOG

7-2-64

Date: July 2, 1964, Driller: Robert E. Raloff Co. County: Grenada

(Name)

(1) Owner of Land: <u>Tom Brewster</u> (Name)	Description & Color of Materials Sand, Clay, Red Clay, Shell, etc.	Thick- ness Feet	Depth Feet
<u>Grenada, Miss</u> (Address)	<u>land</u>	0	18
(2) Location: _____ 1/4, _____ 1/4, Sec. _____ T. _____ R. _____	<u>shale</u>	18	36
_____ miles _____ of _____ (distance) (direction) (Nearest Town)	<u>land</u>	36	72
(3) Topography: <u>Hilly</u> (Hilly) (Flat) (Level)	<u>shale</u>	36	108
(4) Purpose of Well: <u>Domestic</u> (Domestic Irrigation Municipal, Industrial, Other)	<u>land</u>	64	172
	<u>shale</u>	80	252
	<u>land</u>	100	352


Information upon completion of well:

- (1) Diameter 2 inches.
- (2) Total Depth 180 feet.
- (3) Water Level 1 feet below top of ground.
- (4) Cased to 180, Size 2"
- (5) Screen: Size 2", Length 5'
- (6) Were any formations sealed against pollution?  
 yes,  no.

If YES depth of formation \_\_\_\_\_

Why \_\_\_\_\_

Drillers Remarks: \_\_\_\_\_

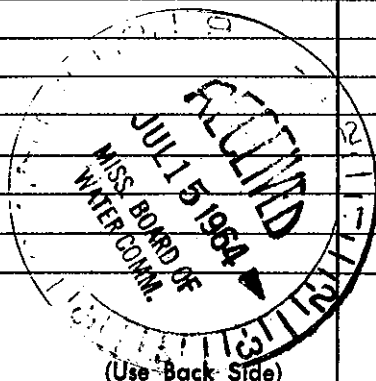

Well No.

Mail this copy to Board of Water Commissioners 429 Miss. St. Jackson, Miss.