

GRENADA MISSISSIPPI BOARD OF WATER COMMISSIONERS

H

WATER WELL DRILLERS LOG

7-2-64

Date: July 2, 1964, Driller: Robert F. Rattiff County Grenada
(Name)

	Description & Color of Materials Sand, Clay, Red Clay, Shell, etc.	Thick- ness Feet	Depth Feet
(1) Owner of Land: <u>Harriet West</u> <small>(Name)</small> <u>Grenada, Miss.</u> <small>(Address)</small>	<u>Red clay sand</u>	<u>0</u>	<u>29</u>
(2) Location: _____ 1/4, _____ 1/4, Sec. _____ T. _____ R. _____	<u>sand + shale streak</u>	<u>29</u>	<u>44</u>
_____ miles _____ of _____ <small>(distance) (direction) (Nearest Town)</small>	<u>" " "</u>	<u>44</u>	<u>66</u>
(3) Topography: <u>Hilly</u> <small>(Hilly) (Flat) (Level)</small>	<u>sand</u>	<u>66</u>	<u>272</u>
(4) Purpose of Well: <u>Domestic</u> <small>(Domestic Irrigation Municipal, Industrial, Other)</small>	<u>shale</u>	<u>272</u>	<u>515</u>
	<u>sand</u>	<u>515</u>	<u>530</u>


Information upon completion of well:

- (1) Diameter 4x2 inches.
- (2) Total Depth 530 feet.
- (3) Water Level 59 feet below top of ground.
- (4) Cased to 530, Size 4x2
- (5) Screen: Size 3" O.D. Length 5"
- (6) Were any formations sealed against pollution?
 yes, _____ no.

If YES depth of formation _____

Why _____

Drillers Remarks: _____

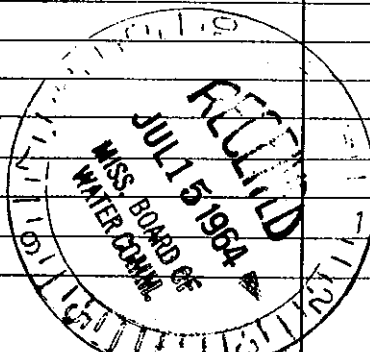

(Use Back Side)

Well No. _____

Mail this copy to Board of Water Commissioners 429 Miss. St. Jackson, Miss.