

GRENADA MISSISSIPPI BOARD OF WATER COMMISSIONERS

H17

4-61

WATER WELL **CODED**

*ok*  
*W.H.L.*


Date: April, 1961, Driller: Robert E. Roth, Jr. County Grenada  
(Name)

(1) Owner of Land: O. J. Neal  
Grenada Club Rd  
Grenada, Miss  
(Name) (Address)  
(2) Location: 1/4, 1/4, Sec. 20 22 5  
2 miles South, of Grenada  
(distance) (direction) (Nearest Town)  
(3) Topography:  (Hilly)  (Flat)  (Level)  
(4) Purpose of Well: domestic  
(Domestic Irrigation, Municipal, Industrial, Other)

Description & Color of Materials Sand, Clay, Red Clay, Shell, etc.	Thick- ness Feet	Depth Feet
Surface soil	0	20
Sandy clay	20	100
WB Sand	100	265
Sand & Lignite	265	325
Hard sandy shale	325	459
Rock & clay	459	474
Sand	474	484
Sandy clay	484	492
Sand	492	509
Clay	509	513

Information upon completion of well:

(1) Diameter 4x2 inches.  
(2) Total Depth 509 feet.  
(3) Water Level 20 feet below top of ground.  
(4) Cased to depth Size 4x2  
(5) Screen: Size 2", Length 10' @ 503-513  
5' @ 474-484  
(6) Were any formations sealed against pollution?  
 yes,  no.

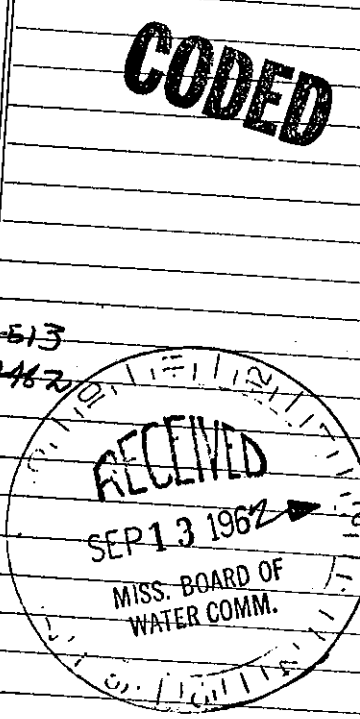

If YES depth of formation cased  
Why \_\_\_\_\_

Drillers Remarks: \_\_\_\_\_  
\_\_\_\_\_  
\_\_\_\_\_

Well No.

(Use Back Side)  
Mail this copy to Board of Water Commissioners 429 Miss. St. Jackson, Mis