

H/8 **GRENADE WATER WELL DRILLERS LOG**

CODED

Date: 6-13-61, 1961, Driller: Luther Hatfield County Grenada
 (Name)

(1) Owner of Land: Edlyn McConick
 (Name)
Grenada, Miss
 (Address)

(2) Location: 2 2 1/2
 (distance) miles (direction) of (Nearest Town)

(3) Topography: _____
 (Hilly) (Flat) (Level)

(4) Purpose of Well: _____
 (Domestic Irrigation, Municipal, Industrial, Other)

Description & Color of Materials Sand, Clay, Red Clay, Shell, etc.	Thick- ness Feet	Depth Feet
Clay & Sand	0	25
Sand & Clay	25	47
Sand & Clay	47	69
Sand & Shale	69	91
Sand & Shale	91	113
Shale & rock	113	135
Shale	135	157
Shale	157	179
Shale & Sand	179	201
Shale & Sand	201	223
Sand & Shale	223	245

Information upon completion of well:

(1) Diameter 2 inches.

(2) Total Depth 241 feet.

(3) Water Level 27 feet below top of ground.

(4) Cased to 245, Size 2"

(5) Screen: Size 2" , Length 10'


(6) Were any formations sealed against pollution?
 _____ yes, _____ no.

If YES depth of formation _____

Why _____

Drillers Remarks: _____

CODED

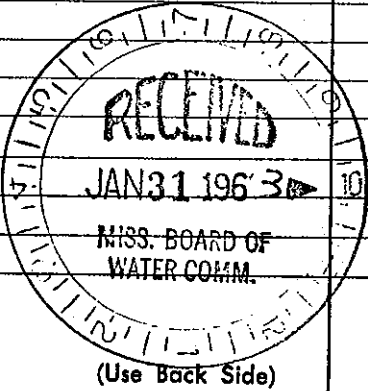

Well No.

Mail this copy to Board of Water Commissioners 429 Miss. St. Jackson, Miss