

**GRENA DA** MISSISSIPPI BOARD OF WATER COMMISSIONERS


H 55

8-18-62

**WATER WELL DRILLERS LOG**

Date: Aug. 18, 1962, Driller: Robert E. Ratliff County: Grenada  
(Name)

(1) Owner of Land: <u>M<sup>c</sup>Quay, Inc.</u> <small>(Name)</small>	Description & Color of Materials Sand, Clay, Red Clay, Shell, etc.	Thick- ness Feet	Depth Feet
<u>Grenada, Mississippi</u> <small>(Address)</small>	Clay	0	15
(2) Location: <u>SE 1/4, SW 1/4, Sec. 32 T. 2 R. 5</u>	Sand	15	35
<u>_____</u> miles, of <u>_____</u> <small>(distance) (direction) (Nearest Town)</small>	Shale	35	40
(3) Topography: <u>_____</u> <small>(Hilly) (Flat) (Level)</small>	Sand	40	120
(4) Purpose of Well: <u>Industrial</u> <small>(Domestic Irrigation Municipal, Industrial, Other)</small>	Shale	120	157
Information upon completion of well:	Rock	157	158
(1) Diameter <u>12</u> inches.	Shale	158	165
(2) Total Depth <u>487</u> feet.	Sand	165	270
(3) Water Level <u>19</u> feet below top of ground.	Shale	270	285
(4) Cased to <u>440</u> , Size <u>12</u>	Sand	285	325
(5) Screen: Size <u>6"</u> , Length <u>40'</u>	Shale	325	330
(6) Were any formations sealed against pollution? <u>yes</u> , _____ no.	Fine Sand	330	380
If YES depth of formation <u>440 feet</u>	Hard Shales	380	440
Why _____	White Sand	440	487
Drillers Remarks: _____			
<u>250 gpm</u>			

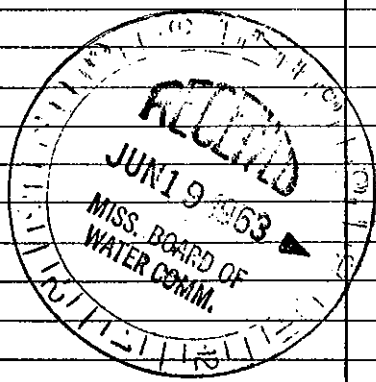

(Use Back Side)

Well No.

Retain this copy for your office files.