

MS-GW-02665

GRENADA MISSISSIPPI BOARD OF WATER COMMISSIONERS

H 57
11-62

WATER WELL DRILLERS LOG

Date: Nov, 1962, Driller: Robert E. Ritzoff County Grenada
(Name)

(1) Owner of Land:	Description & Color of Materials Sand, Clay, Red Clay, Shell, etc.	Thick- ness Feet	Depth Feet
<u>Grenada Industries</u> (Name)	<u>0 - 35 top soil</u>		
<u>Grenada, Miss</u> (Address)	<u>35 - 50' sandy</u>		
(2) Location: <u>NW 1/4, SE 1/4, Sec. 18 T 22 S</u>	<u>50 - 150 Hard shale</u>		
_____ miles _____ of <u>Grenada</u> (distance) (direction) (Nearest Town)	<u>150 - 210 white sand</u>		
(3) Topography: <u>Level</u> (Hilly) (Flat) (Level)			
(4) Purpose of Well: <u>Industrial</u> (Domestic Irrigation Municipal, Industrial, Other)			


Information upon completion of well:

- (1) Diameter 12 inches.
- (2) Total Depth 210 feet.
- (3) Water Level 52 feet below top of ground.
- (4) Cased to 150', Size 12
- (5) Screen: Size 6", Length 40'
- (6) Were any formations sealed against pollution?
 yes, _____ no.

If YES depth of formation Cemented

Why _____

Drillers Remarks: 350 gpm

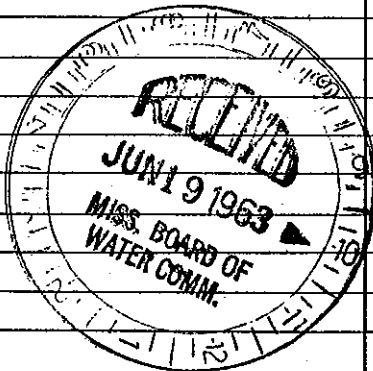

Well No.

(Use Back Side)

Mail this copy to Board of Water Commissioners 429 Miss. St. Jackson, Miss