

Grenada
H 65
7-67

MISSISSIPPI
BOARD OF WATER COMMISSIONERS
416 North State Street
Jackson, Mississippi 39201

WATER WELL DRILLERS LOG

July 1967 date well completed
Robert E. Katelylls firm name
Grenada county well located


LANDOWNER: Hankins
Lumber Co.
Elliott Miss.
(mailing/address)

WELL LOCATION:
sec. 14 T. 21 N. R. 5 E
5 miles South of Grenada
(distance) (direction) (nearest town)

WELL PURPOSE: Industrial
(home, irrigation, municipal, industrial)

WELL COMPLETION DATA:
(1) diameter (inches) 4 x 2
(2) total depth (feet) 478
(3) static water level (feet) 25 below above top of ground.
(4) casing galv. 468'
(material) (depth)
333-2
135-2 If telescope see back.
(size)
(5) screen 10 468
(length) (depth to top)
2" S.S.
(size) (material)
(6) pump 5 30
(HP) (yield gpm)
electric
(type power)
(7) electric log No.
(yes or no)
(organization running log)
(8) how well bottom plugged BPV.

description of formations encountered	from	to
Duckshot sand	0	22
sand + shale	22	66
shale, sand streaks	66	88
sand	88	126
shale	126	142
sand	142	153
shale	153	197
shale, sandy	197	339
shale	339	394
shale, sand streaks	394	437
sand	437	438
Green fine sand	438	452
fine white sand	452	459
shale	459	472
sand	472	477

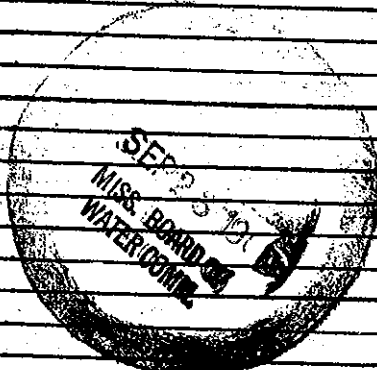

DRILLERS REMARKS: