

Grenada
H66
12-67

MISSISSIPPI
BOARD OF WATER COMMISSIONERS
416 North State Street
Jackson, Mississippi 39201

checked

WATER WELL DRILLERS LOG

Dec. 21 1967 date well completed
Robert S. Poff firm name
Grenada, Miss county well located

LANDOWNER: <u>Quel Patton</u> <u>234 First Street</u> <u>Grenada, Miss</u> (mailing address)	description of formations encountered	from to	
	<u>CLAY</u>	<u>0</u>	<u>22</u>
	<u>SHALE</u>	<u>22</u>	<u>105</u>
	<u>SAND</u>	<u>105</u>	<u>152</u>


WELL LOCATION:
sec 10 T 22 N R 5 E
4 miles East of Grenada
(distance) (direction) (nearest town)

WELL PURPOSE: Home
(home, irrigation, municipal, industrial)

WELL COMPLETION DATA:

- (1) diameter (inches) 4"
- (2) total depth (feet) 152
- (3) static water level (feet) 57 below above top of ground.
- (4) casing Galv. 152
(material) (depth)
4"
(size) if telescope see back.
- (5) screen 5 147
(length) (depth to top)
4" x 2" Galv.
(size) (material)
- (6) pump 3/4 15
(HP) (yield gpm)
Electric
(type power)
- (7) electric log No
(yes or no)

(organization running log)
- (8) how well bottom plugged B.P.V.

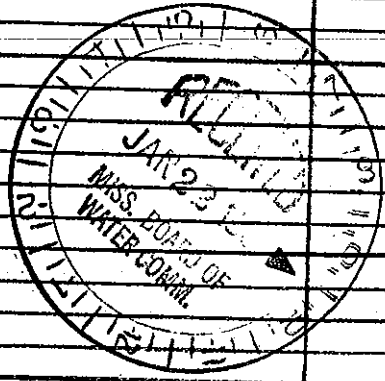

DRILLERS REMARKS: