

10/75

Gw02690
0220063-03

TRANSMITTED FOR ADP

Recorded by JAC
Date 11/1/76

U.S. GEOLOGICAL SURVEY
WATER RESOURCES DIVISION
MISSISSIPPI DISTRICT
WELL RECORD

477

Well No. H 97
E-Log No. _____
County GRENADA

Site ID 334810089480701 R=0* T=AM* 2=W* Grenada Quad

Data reliab. 3=CU* Report. agency 4=USGS* Dist. 6=28* 7=28* Co. 8=043*

Lat. _____ Long. 9=3348* 10=0894807* Well No. 12=H097*

Location SW SW 13=S 1/4 NW 1/4 S 0.5 T 22 N R 0.5 E* Alt. 16=170* 183

Hyd. Unit (OWDC) 20= _____ Date 21=1010011969*

Well use 23=W* Water Use 24=N* Hole depth 27= _____ Well depth 28=210*

WL 30=10* Date 31=1010011969* Source 33=D*

Status 273= _____*

R=158* T=AM* Date 159# 1010011969* Owner No. #3

Owner 161=N. AMERICAN ROCKWELL*

Randall Textron

R=192* T=A M* Date 193# _____* Temp. 196#00010* 197= _____*

R=192* T=A M* Date 193# _____* Cond. 196#00095* 197= _____*

R=192* T=A M* Date 193# _____* pH 196#00400* 197= _____*

R=58* T=AM* 59# 1* Date 60=1010011969* Remarks _____

Drlg. 63=060* Name Robert Balluff Method 65=H* Finish 66=S*

R=76* T=AM* 59# 1*

Top csng. 77# 0* Bot. csng. 78=130* Diam. 79# 30*

R=76* T=A M* 59# 1*

Top csng. 77# _____* Bot. csng. 78= _____* Diam. 79# _____*

R=82* T=AM* 59# 1* Top 83# 30* Bottom 84=210*

Type 85=S* Diam. 87=10* Size 88= _____*

R=82* T=A M* 59# 1* Top 83# _____* Bottom 84= _____*

Type 85= _____* Diam. 87= _____* Size 88= _____*

R=134 146* T=AM* 147# 1* Q 150=1600* Q/S 272= _____*

0738000
20-6000000

LIFT

R=42* T= A M * Lift type 43# T Intake 44= 80 * Power type 45= E *

Date 38= 10/00/1969 * H.P. 46= 150. *

LOGS

R=198* T= A M * Log 199# * Top 200= * Bot 201= *

R=198* T= A M * Log 199# * Top 200= * Bot 201= *

R=189* T= A M * E Log No. 190# * 191= M I S S D I S T *

ANAL.

R=114* T= A M * Year 115# * Type 120= *

AQUIFERS

R=90* T= A M * 256# 1 * Top 91= * Bot 92= *

Unit ID 93= 1,24 WLCXM * Name of Unit MUNX

R=90* T= A M * 256# 1 * Top 91= * Bot 92= *

Unit ID 93= * Name of Unit _____

HYDRAULICS

R=98* T= A M * 99# 1 * Unit tested 100= *

R=105* T= A M * 99# 1 * Test No. 106# *

107= * Transmissivity (gal/d)/ft _____

108= * Hydraul. cond. (gal/d)/ft² _____

110= * Storage coeff. Boundaries _____

3" DD 55' according to Ratliff.
1600 gpm @ 70'

DEPARTMENT OF ENVIRONMENTAL QUALITY - OLWR
PUBLIC SUPPLY WELLS PROJECT
GPS LOG

USER NAME(S): Phillips/Hardin DATE: 11/4/97
UNIT DEQ #: _____ FILE #: R0110418B
HEALTH DEPT. #: 220063-03 (No tag) ELEV. 183
USGS #: H97 OLWR #: GW02690
OWNER: Randall Textron QUAD: Grenada
LOCATION: SW/SW/SE/NW NE/SW S 5 T 22N R 5E COUNTY: Grenada
LOCATION DESCRIPTION: At rear of and to the south of
plant
CASING DIA: _____ PUMP TYPE & SIZE: Turbine, 150 HP
GPS FIELD LOCATION: LAT. 33°48'06.1"N LONG. 89°47'58.4"W
GPS CORRECTED LOCATION: LAT. 33.801745 LONG. 89.799888
REMARKS: Measured 18' north of well

DEPARTMENT OF ENVIRONMENTAL QUALITY - OLWR-

PUBLIC SUPPLY WELLS PROJECT

GPS LOG

USER NAME (S) : **RLB DC** DATE : **10-11-2002**

UNIT DEQ # : _____ FILE # : _____

HEALTH DEPT. **220063-03** : _____

USGS # : **h097** OLWR # : **ms-gw-02690**

OWNER : **randall -textron** QUAD : **GRENADA**

LOCATION : _____ S _____ T _____ R _____ COUNTY **GRENADA**

LOCATION DESCRIPTION : **½ mile so. Tower, field well**

CASING DIA : PUMP TYPE & SIZE : _____

GPS FIELD LOCATION : LAT. **33.80174** **-89.79993**

GPS CORRECTED LOCATION : LAT. _____ LONG. _____

REMARKS :

P000763 sent to Wayne

DEPARTMENT OF ENVIRONMENTAL QUALITY - OLWR

PUBLIC SUPPLY WELLS PROJECT

GPS LOG

USER NAME (S) : KLB DC DATE: 10-11-2003

UNIT NO : FILE NO :

HEALTH DEPT: 22003-03

USER NO: OLWR 8: ms-gw-0303

CAMPER: GARD: GRENADA

LOCATION: COUNTY GRENADA

LOCATION DESCRIPTION: 12 mile sq. Tower field well

CASING DIA: PUMP TYPE & SIZE:

ORG FIELD LOCATION: LAT: 12.80174 -83.9923


GPS CORRECTED LOCATION: LAT: LONG:

REMARKS:

PHOTO

Randall TEXTRON MS-GW-02690
HO97 GRENADA CO. 10-11-2002



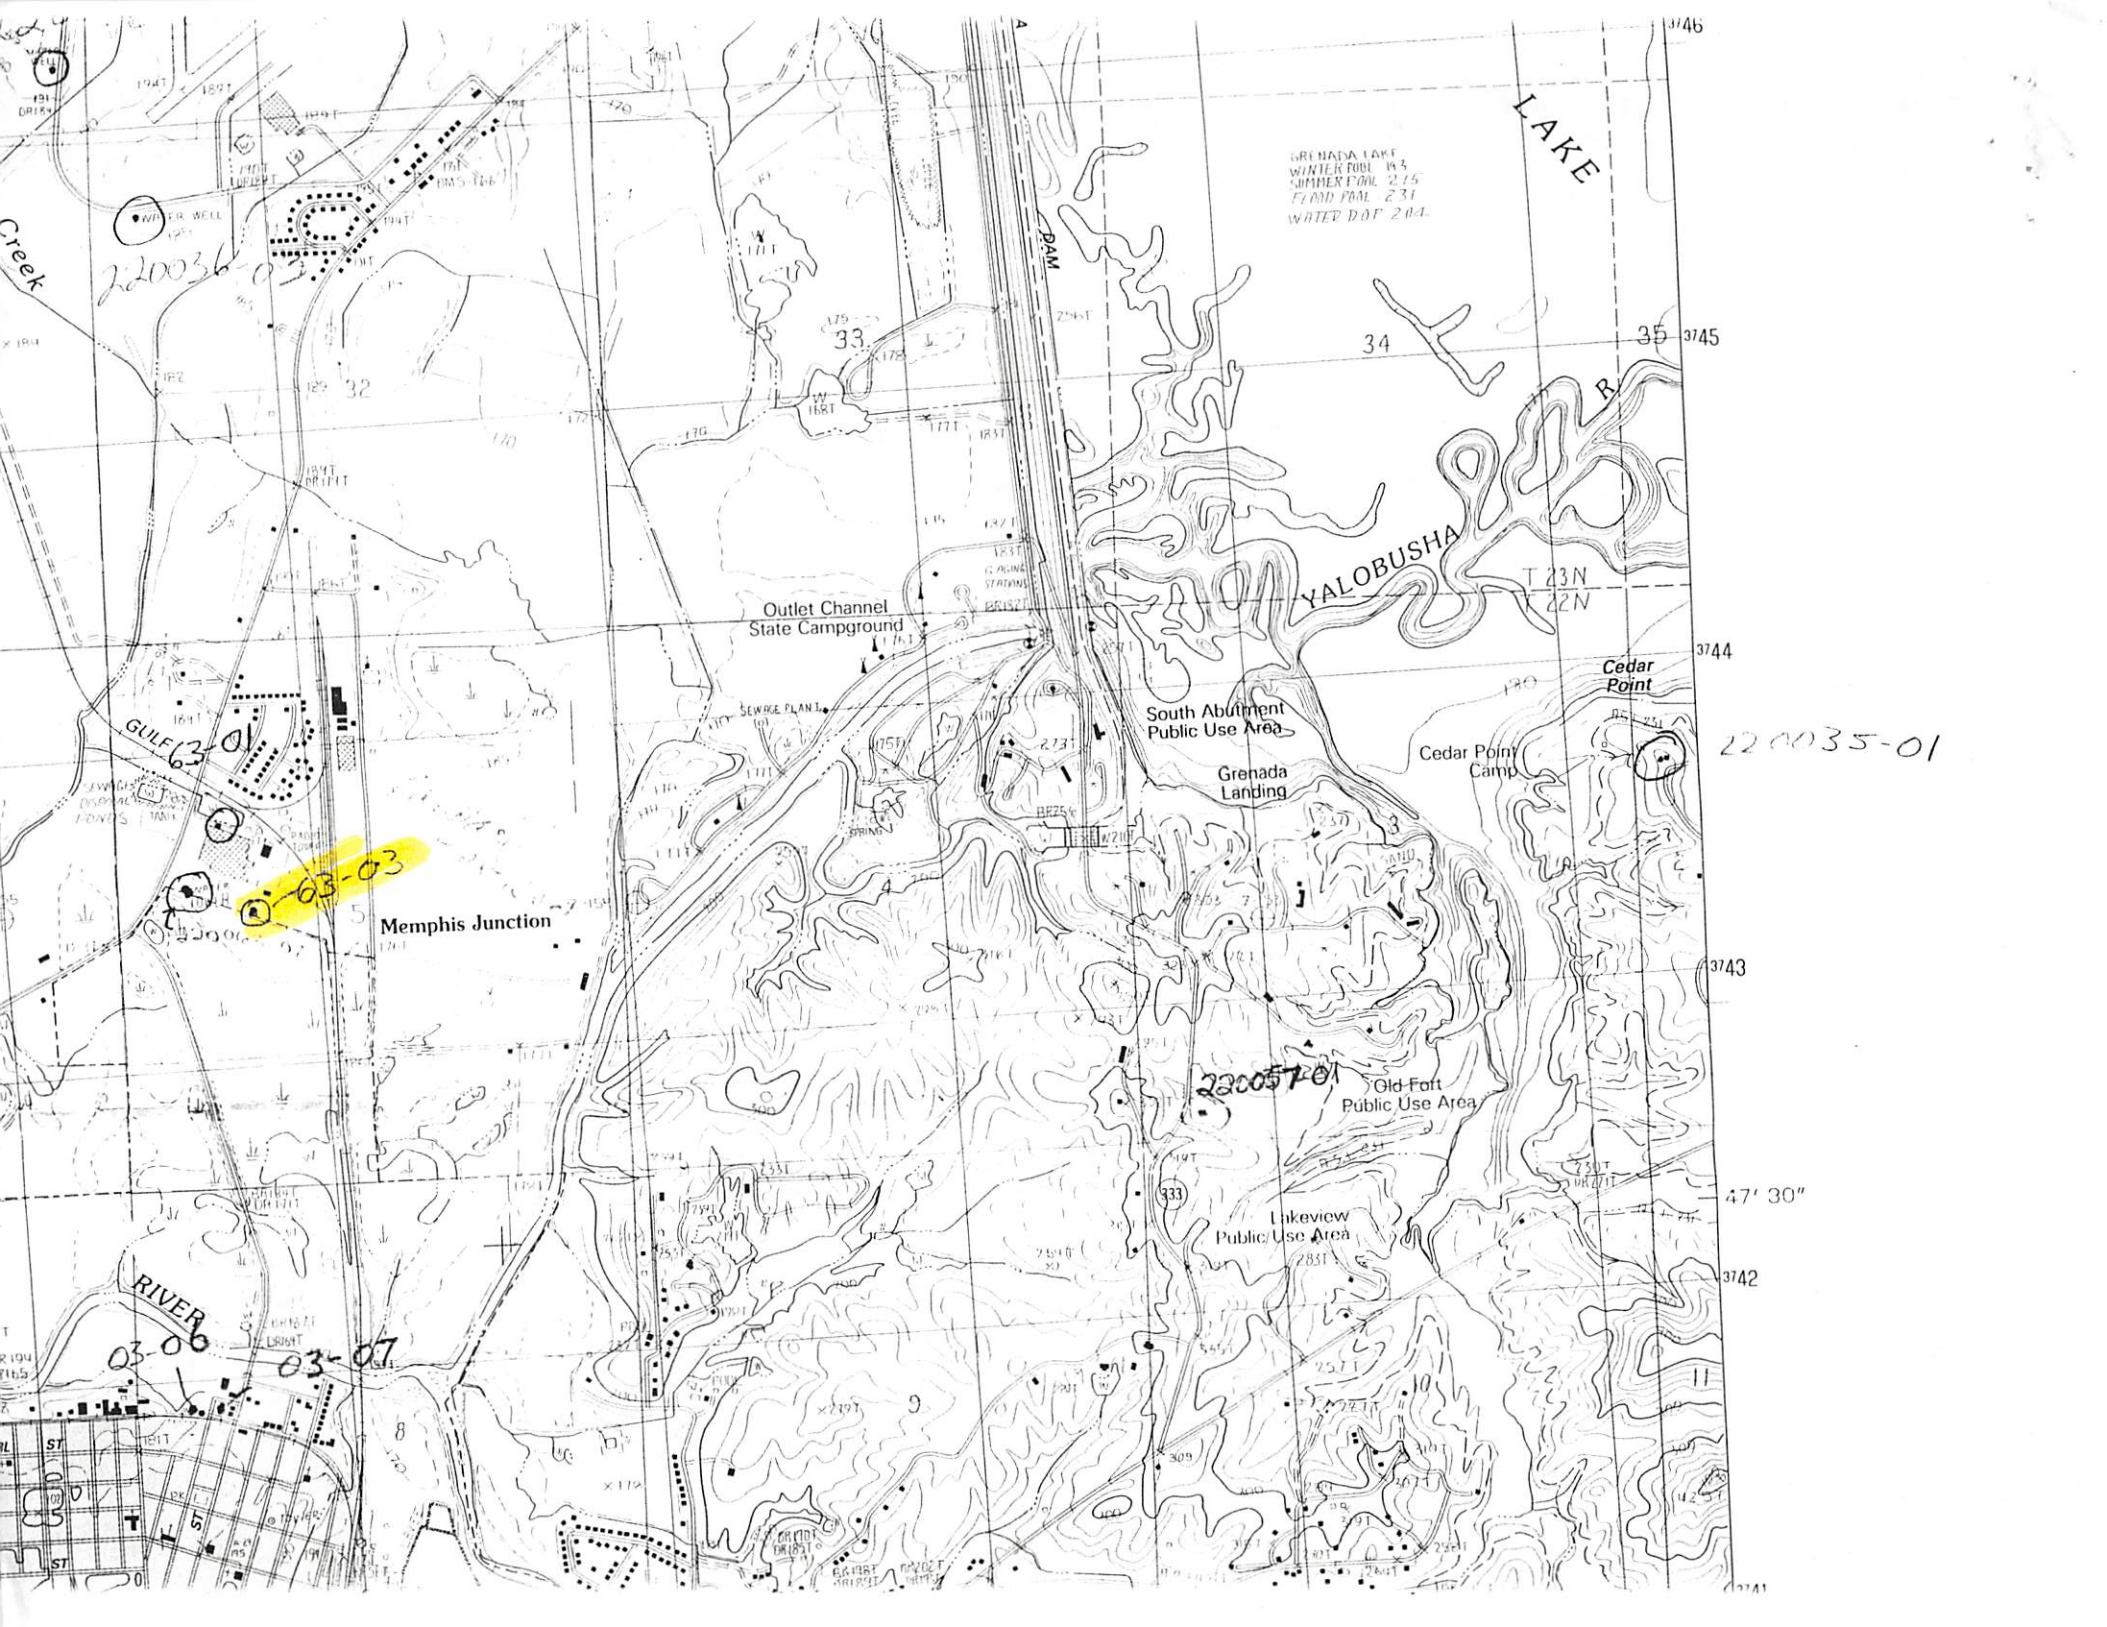

220036-03

03-03

220035-01

220057-01

03-03 03-07

SRI BADA LAKE
WINTER POOL 18.5
SUMMER POOL 2.25
FLOOD POOL 2.31
WATER DAP 2.04

Creek

LAKE

YALOBUSHA

T 23N
R 34E

Outlet Channel
State Campground

South Abutment
Public Use Area

Grenada
Landing

Cedar Point
Camp

Cedar
Point

Old Fort
Public Use Area

Lakeview
Public Use Area

Memphis Junction

RIVER

ST
ST
ST

3746

35 3745

34

3744

3743


47' 30"

3742

3741



Target is 33.8017°N, 89.7999°W - GRENADA quad [Quad Info]

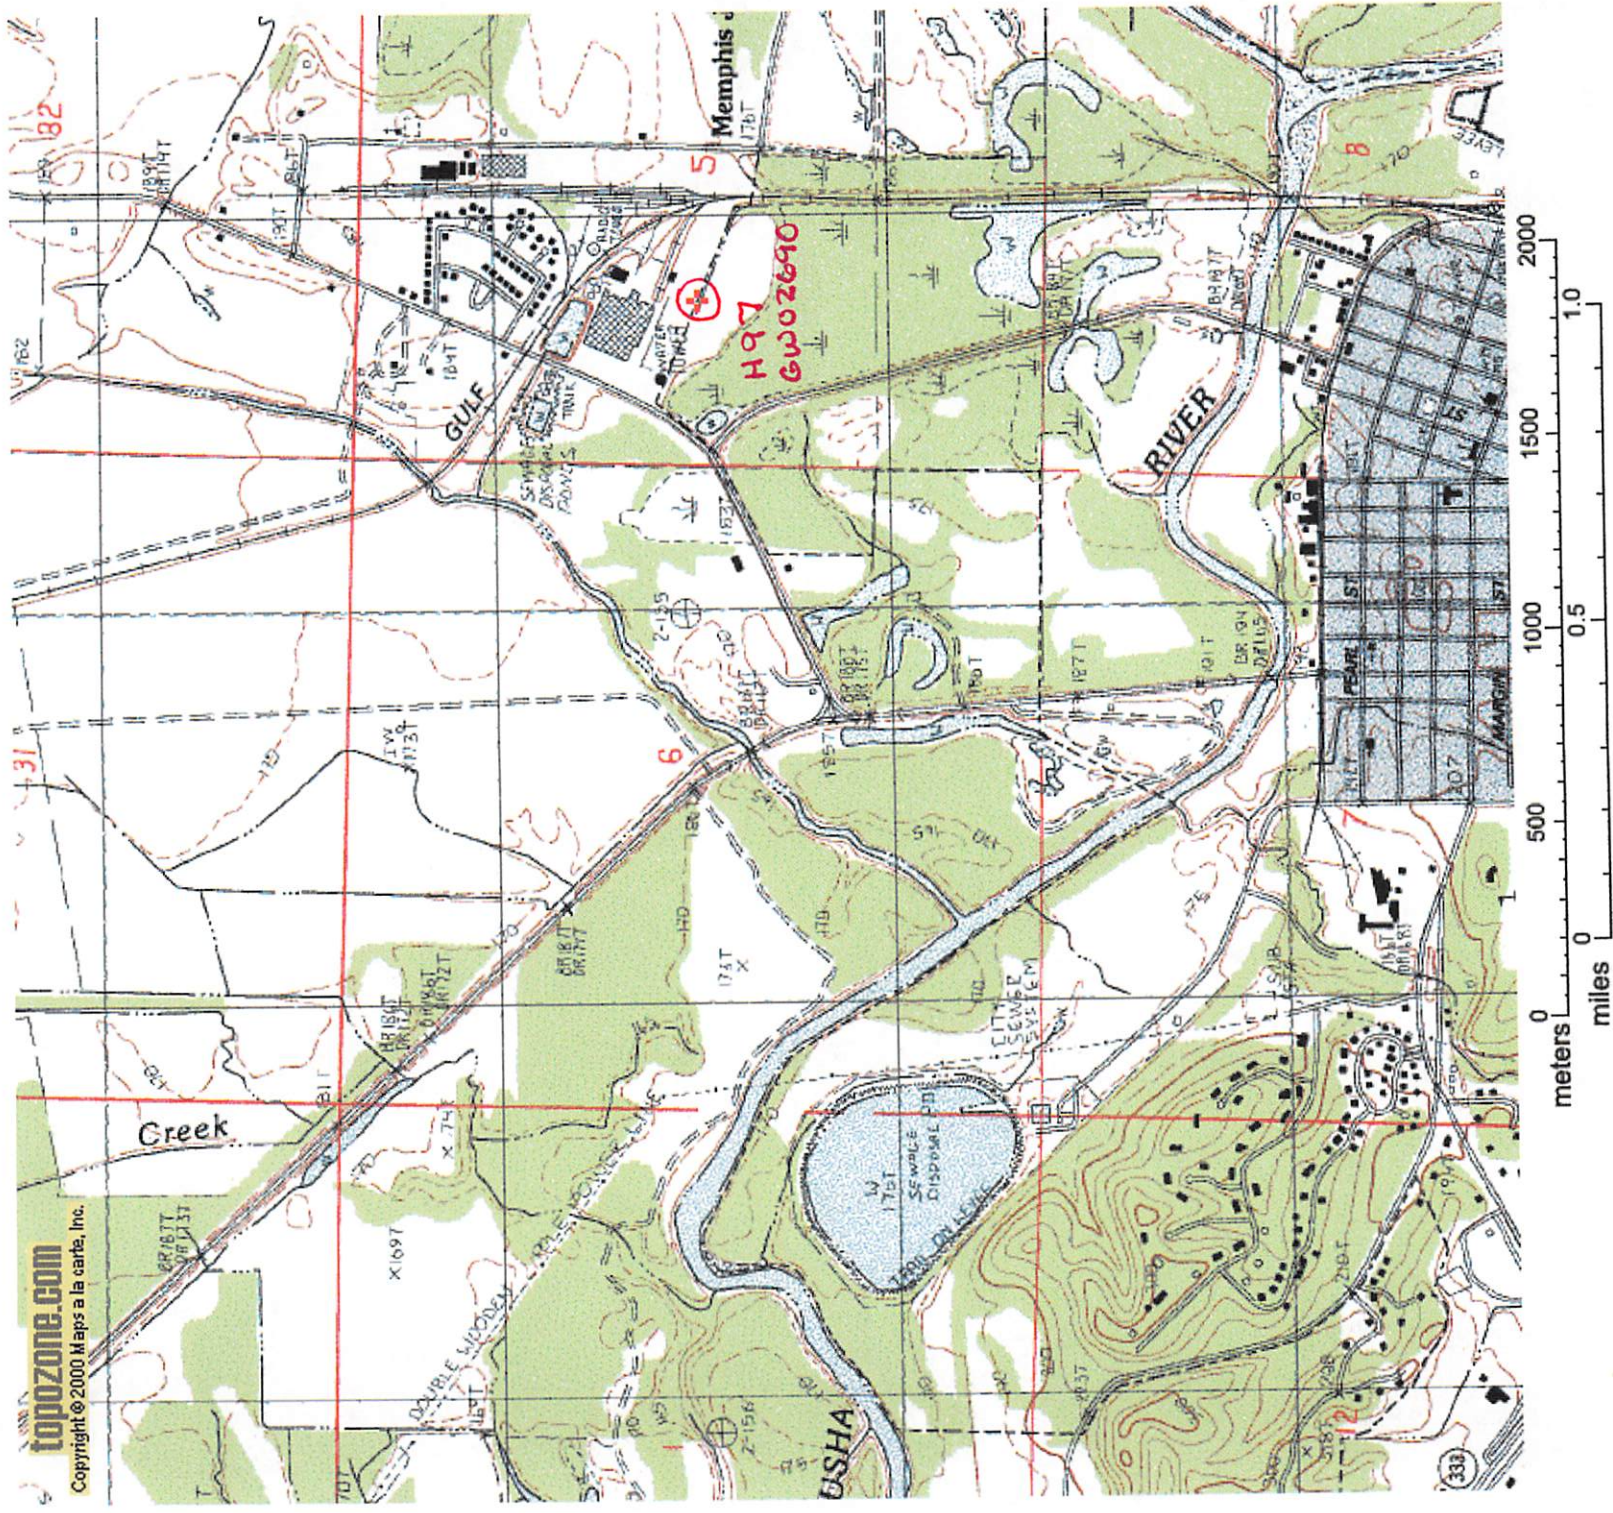

The TopoZone is produced by Maps a la carte, Inc. - © 2000 Maps a la carte, Inc. - All rights reserved. Use of this site is governed by our [Conditions of Use](#). We care about your privacy - please consult our [Privacy Statement](#) for details.