

Grenada

MISSISSIPPI BOARD OF WATER COMMISSIONERS

H116


GW03886

10-66

WATER WELL DRILLERS LOG

E Log 41

Date: Oct. 1, 1966, Driller: Layne-Central Co. County Grenada

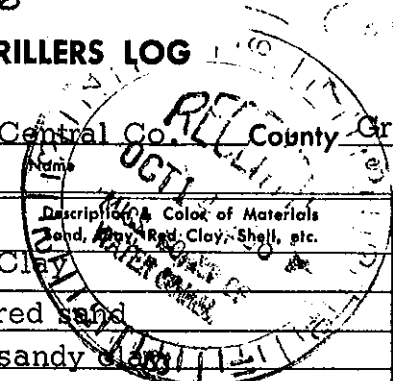

(1) Owner of Land: U. S. Engineers- (Name)

Grenada Dam, Mississippi (Address)

(2) Location: NE SE 1/4, NE 1/4, Sec. 4 T. 22N R. 5E

miles of (distance) (direction) (Nearest Town)

(3) Topography: (Hilly) (Flat) (Level)

(4) Purpose of Well: Drinking Water Supply (Domestic Irrigation Municipal, Industrial, Other)

Information upon completion of well:

(1) Diameter 10 inches.

(2) Total Depth 568 feet.

(3) Water Level 70 feet below top of ground.

(4) Cased to 533', Size 10"

(5) Screen: Size 6", Length 30'

(6) Were any formations sealed against pollution?

x yes, no.

If YES depth of formation 533'

Why required

Drillers Remarks:

Table with 3 columns: Description & Color of Materials (Sand, Clay, Red Clay, Shell, etc.), Thickness Feet, Depth Feet. Rows include clay, red sand, sandy clay, shale, sand, sandy clay, sand, clay, sandy clay, clay, rock, sandy clay, clay, rock, clay, sand, clay, rock, clay.

Well No.

(Use Back Side)

Mail this copy to Board of Water Commissioners 429 Miss. St. Jackson, Miss.