

Now City of Grenada

Grenada
H 122
10-66
Elec. Log

MISSISSIPPI
BOARD OF WATER COMMISSIONERS
416 North State Street
Jackson, Mississippi 39201

WATER WELL DRILLERS LOG

date well completed Oct 1966 19 firm name Robert E. Kattuff county well located Grenada

LANDOWNER: Elliott Water Assn. Inc.
Elliott, Miss.
(mailing address)


WELL LOCATION:
sec. 14 T. 21 N. R. 5 E. S. 2 W.
miles in Elliott
(distance) (direction) (nearest town)

WELL PURPOSE: municipal
(home, irrigation, municipal, industrial)

WELL COMPLETION DATA:

- (1) diameter (inches) 8 x 4
- (2) total depth (feet) 466
- (3) static water level (feet) 29 below top of ground.
- (4) casing St. 439'
(material) (depth)
- 8 x 4 If telescope see back.
(size)
- (5) screen 30 439
(length) (depth to top)
- .020 5.5
(size) (material)
- (6) pump 20 137
(HP) (yield gpm)
- turbine
(type power)
- (7) electric log yes (yes or no)
M. G. S. E Log # 39
(organization running log)
- (8) how well bottom plugged BPU

description of formations encountered	from	to
Top Soil + Yellow Sand	0	25
Shale	25	75
White Sand	75	145
Sand, Shale	145	158
Sand	158	175
Shale	175	181
sand	181	210
Shale	210	336
Hard Rock	336	339
Shale	339	366
Sand	366	374
Bumbo	374	428
Sand	428	434
Bumbo	434	440
Sand	440	454
Bumbo	454	458
Sand	458	466

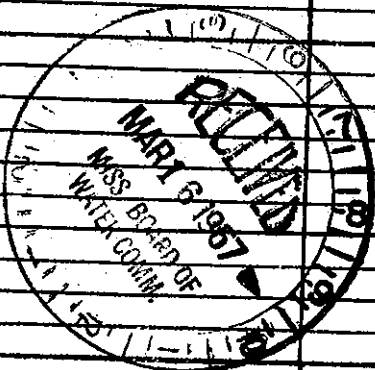

DRILLERS REMARKS: