

OH 124

4-15-64

WATER WELL DRILLING LOG

CODED

CODED

Date April 15, 1964, Driller: Robert E. Ratliff County Grenada
(Name)

(1) Owner of Land: Mess. Ldg # 1973
(Name)
Grenada, Miss.
(Address)

(2) Location: 5 22 5
1/4, 1/4, Sec. T. R.
3 miles north, of Grenada
(distance) (direction) (Nearest Town)

(3) Topography: flat
(High) (Flat) (Level)

(4) Purpose of Well: domestic
(Domestic Irrigation, Municipal, Industrial, Other)

Description & Color of Materials Sand, Clay, Red Clay, Shell, etc.	Thick- ness Feet	Depth Feet
sand, clay	25	25
shale	24	49
shale	23	72
shale, sand strks.	24	96
sand	24	120
sand	23	143
sand	24	167
sand, shale strks.	24	191
shale	23	214
shale	5	219
shale - sand strks	22	241
sand	11	252
shale, sand strks	11	263
shale	22	285
shale	22	307
shale	22	329
shale	21	350
shale, sand strks	22	372
shale	22	394
shale	22	416
shale - rock	7	423
shale	15	438
shale	21	459
shale	19	478
shale	3	481
shale	18	499
sand	6	505
	8	
	11	
	19	
	20	

Information upon completion of well:

(1) Diameter 4" inches.

(2) Total Depth 505 feet.

(3) Water Level 8 feet above ground. below top of

(4) Cased to 485', Size 2" x 4"


(5) Screen: Size 2", Length 20'

(6) Were any formations sealed against pollution?
 yes, no.

If YES depth of formation Top 10' cemented

Why _____

Drillers Remarks: _____

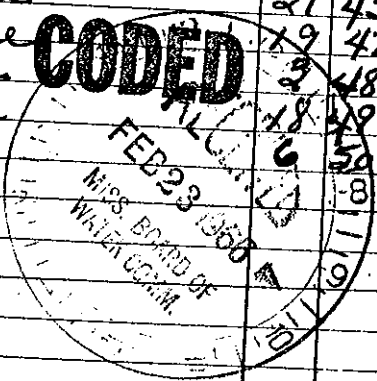

Well No.

(Use Back Side)