

GRENADA MISSISSIPPI BOARD OF WATER COMMISSIONERS

H 125  
9-16-64

WATER WELL DRILLERS LOG

**CODED**

Date: Sept. 16, 1964, Driller: Robert E. Raloff County Grenada  
(Name)


(1) Owner of Land:	Description & Color of Materials Sand, Clay, Red Clay, Shell, etc.	Thick- ness Feet	Depth Feet
<u>Hay Branscome</u> (Name) <u>Grenada</u> (Address)	<u>Red clay sand</u>	0	23
(2) Location: <u>22</u> <u>33</u> <u>225</u> 1/4, 1/4, Sec. T R	<u>sand</u>	23	44
<u>4</u> miles <u>South</u> of <u>Grenada</u> (distance) (direction) (Nearest Town)	<u>sandy shale streaks</u>	44	65
(3) Topography: <u>Flat</u> (Hilly) (Flat) (Level)	<u>sand</u>	65	123
(4) Purpose of Well: <u>Domestic</u> (Domestic Irrigation Municipal, Industrial, Other)			

Information upon completion of well:

- (1) Diameter 2 inches.
- (2) Total Depth 120 feet.
- (3) Water Level 24 feet below top of ground.
- (4) Cased to 120, Size 2
- (5) Screen: Size 3" or Length 4'
- (6) Were any formations sealed against pollution?  
 yes,  no.

If YES depth of formation \_\_\_\_\_  
Why \_\_\_\_\_  
Drillers Remarks: \_\_\_\_\_

**CODED**

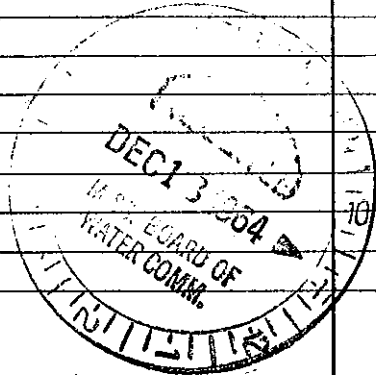

Well No. \_\_\_\_\_

(Use Back Side)

Mail this copy to Board of Water Commissioners 429 Miss. St. Jackson, Miss.