

GRENADA MISSISSIPPI BOARD OF WATER COMMISSIONERS

**CODED**

H 126

10-28-64

WATER WELL DRILLERS LOG

Date: 10-28, 1964, Driller: J B Cain County Parola

(Name)

(1) Owner of Land:	Description & Color of Materials Sand, Gray, Red Clay, Shell, etc.	Thick- ness Feet	Depth Feet
<u>H A S Hook</u> (Name) <u>Grenada Miss</u> (Address)	<u>Clay</u> <u>Sand</u>	<u>0</u> <u>110</u>	<u>110</u> <u>150</u>
(2) Location: <u>10 22 5</u> $\frac{1}{4}$ , $\frac{1}{4}$ , Sec. <u>T R</u>			
<u>4</u> miles <u>E</u> of <u>Grenada</u> (distance) (direction) (Nearest Town)			
(3) Topography: <input checked="" type="checkbox"/> (Hilly) <input type="checkbox"/> (Flat) <input type="checkbox"/> (Level)			
(4) Purpose of Well: <u>Home</u> (Domestic Irrigation, Municipal, Industrial, Other)			

**CODED**


Information upon completion of well:

- (1) Diameter 4 inches.
- (2) Total Depth 150 feet.
- (3) Water Level 80 feet below top of ground.
- (4) Cased to 150, Size 4"
- (5) Screen: Size 2, Length 5 FT  
Plastic Chauled
- (6) Were any formations sealed against pollution?  
\_\_\_\_\_ yes, \_\_\_\_\_ no.

If YES depth of formation \_\_\_\_\_

Why \_\_\_\_\_

Drillers Remarks: \_\_\_\_\_

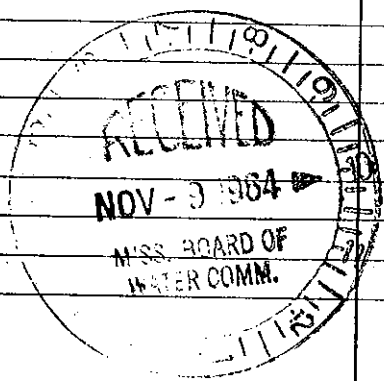

(Use Back Side)

Well No. \_\_\_\_\_

Mail this copy to Board of Water Commissioners 429 Miss. St. Jackson, Miss.