

**GRENADE** MISSISSIPPI BOARD OF WATER COMMISSIONERS

**CODED**

H 127

7-15-65

**WATER WELL DRILLERS LOG**

Date: July 15, 1965, Driller: Raluit E. Rottliff County Grenada  
(Name)

(1) Owner of Land: Mr. Paul Haza  
(Name)  
Grenada, Miss.  
(Address)

(2) Location: 30 22 S  
1/4, 1/4, Sec. T. R.  
2 miles South, of Grenada  
(distance) (direction) (Nearest Town)

(3) Topography: Flat  
(Hilly) (Flat) (Level)

(4) Purpose of Well: Domestic  
(Domestic Irrigation  
Municipal, Industrial, Other)

Description & Color of Materials Sand, Clay, Red Clay, Shell, etc.	Thick- ness Feet	Depth Feet
<u>Top Soil</u>	<u>18</u>	<u>18</u>
<u>yellow sand</u>	<u>22</u>	<u>40</u>
<u>Shale</u>	<u>110</u>	<u>150</u>
<u>white sand</u>	<u>60</u>	<u>210</u>

**CODED**

Information upon completion of well:


- (1) Diameter 2 inches.
- (2) Total Depth 180 feet.
- (3) Water Level 32 feet below top of ground.
- (4) Cased to 175', Size 2
- (5) Screen: Size 2, Length 5
- (6) Were any formations sealed against pollution?  
4" x 6' x 6' concrete slab  
yes, \_\_\_\_\_ no.

If YES depth of formation \_\_\_\_\_

Why \_\_\_\_\_

Drillers Remarks: \_\_\_\_\_

5' 2" Johnson Stainless  
Steel Screen 906

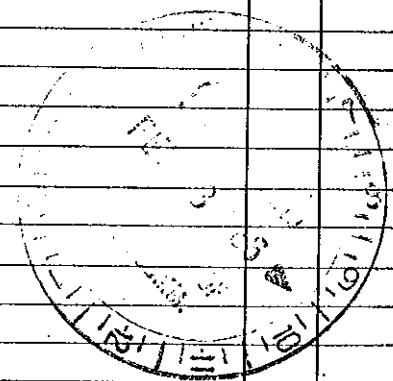

(Use Back Side)

Well No.