

GRENADE MISSISSIPPI BOARD OF WATER COMMISSIONERS

H 128
3-20-66

WATER WELL DRILLERS LOG

CODED

Date: March 20 1966, Driller: Lusk Raddy County Greene
(Name)

(1) Owner of Land: Lawrence Litten
(Name)
Greene, Miss
(Address)

(2) Location: 10 22 5
10 22 5
miles of
(distance) (direction) (Nearest Town)

(3) Topography: _____
(Hilly) (Flat) (Level)

(4) Purpose of Well: Domestic
(Domestic Irrigation
Municipal, Industrial, Other)

| Description & Color of Materials Sand, Clay, Red Clay, Shell, etc. | Thick- ness Feet | Depth Feet |
|-----------------------------------------------------------------------|------------------------|---------------|
| <u>Clay</u> | <u>0</u> | <u>25</u> |
| <u>Clay & sand</u> | <u>25</u> | <u>47</u> |
| <u>sand</u> | <u>47</u> | <u>289</u> |
| <u>Clay</u> | <u>389</u> | <u>377</u> |
| <u>shale</u> | <u>577</u> | <u>443</u> |
| <u>sand</u> | <u>443</u> | <u>509</u> |

Information upon completion of well:

(1) Diameter 4 1/2 inches.
509,

(2) Total Depth 412 feet.

(3) Water Level 40 feet below top of ground.

(4) Cased to all the way Size 4 1/2"

(5) Screen: Size 2" , Length 20"


(6) Were any formations sealed against pollution?
_____ yes, _____ no.

CODED

If YES depth of formation _____

Why _____

Drillers Remarks: Good Water

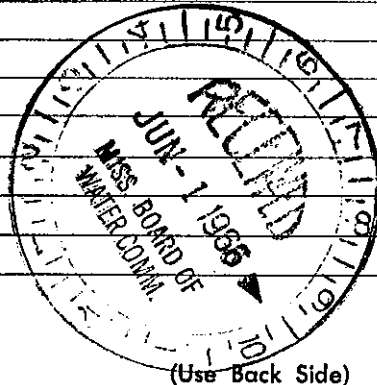

Well No.

Mail this copy to Board of Water Commissioners 429 Miss. St. Jackson, Miss