

GRENADA MISSISSIPPI BOARD OF WATER COMMISSIONERS

J 71
1-1-66

WATER WELL DRILLERS LOG CODED

Date: Jan 1st, 1966, Driller: Luther Ratliff County Grenada
(Name)

(1) Owner of Land:	Description & Color of Materials Sand, Clay, Red Clay, Shell, etc.	Thick- ness Feet	Depth Feet
<u>Roy Charbonin</u> (Name)	Clay + sand	0	25
<u>Gore Spring, Miss</u> (Address)	Clay	25	91
(2) Location: <u>22 226</u> 1/4, 1/4, Sec. T R	Clay + shale	91	113
_____ miles _____ of _____ (distance) (direction) (Nearest Town)	shale	113	355
(3) Topography: _____ (Hilly) (Flat) (Level)	sand	355	509
(4) Purpose of Well: <u>Domestic</u> (Domestic Irrigation Municipal, Industrial, Other)			

CODED


Information upon completion of well:

- (1) Diameter 4 1/2 inches.
- (2) Total Depth 589 feet.
- (3) Water Level 30 feet below top of ground.
- (4) Cased to all the way Size 4 1/2"
- (5) Screen: Size 2" Length 20'
- (6) Were any formations sealed against pollution?
_____ yes, NO no.

If YES depth of formation _____

Why _____

Drillers Remarks: Good water

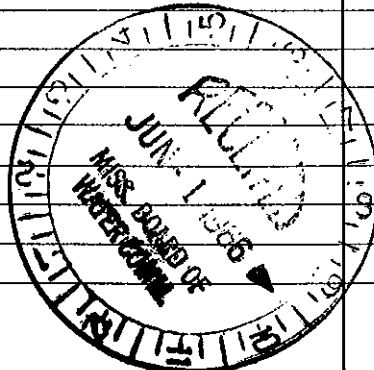

(Use Back Side)

Well No.

Mail this copy to Board of Water Commissioners 429 Miss. St. Jackson, Mi-