

Granada
K 19
5-6-74

MISSISSIPPI
BOARD OF WATER COMMISSIONERS
416 North State Street
Jackson, Mississippi 39201


CODED

WATER WELL DRILLERS LOG

May 6 1974 Charles Lovon Granada
date well completed firm name county well located

LANDOWNER:	description of formations encountered	from	to
Pleasant Grove Baptist Church Pleasant Grove, Miss. (mailing address)	Blue Shale	0	160
	Grey Shale	160	175
	Green Sand	175	180
	Grey Shale	180	220
	Dark Grey Shale & Grey Sand	220	264
WELL LOCATION: sec 22 T 22 N R 7 E 4 miles E of Kosciusko (distance) (direction) (nearest town)			
WELL PURPOSE: Church (home, irrigation, municipal, industrial)			
WELL COMPLETION DATA: (1) diameter (inches) 4" (2) total depth (feet) 264' (3) static water level (feet) 72' below top of ground. (4) casing Plastic 160' (material) (depth) 4" (size) if telescope see back. (5) screen (length) (depth to top) (size) (material) (6) pump 1 (HP) 5 (yield gpm) Electric (type power) (7) electric log no. (yes or no) (organization running log) (8) how well bottom plugged opened Ballou			
DRILLERS REMARKS:			

CODED

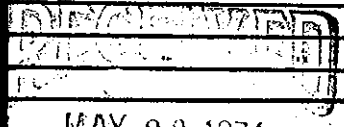

MISS. BD. OF WATER COMM