

Hancock  
A1  
12-6-68

MISSISSIPPI  
BOARD OF WATER COMMISSIONERS CODED  
416 North State Street  
Jackson, Mississippi 39201

WATER WELL DRILLERS LOG

12-6 1968 Penton Well Serv Hancock  
date well completed firm name county well located

LANDOWNER: <u>Karl Goss</u>	description of formations encountered	from	to
<u>Rt 3 - Box 176</u>			
<u>Picayune Miss</u> (mailing address)	<u>" sand</u>	<u>28</u>	<u>75</u>
WELL LOCATION: sec <u>30 T 5 S R 15 E</u>	<u>White Clay</u>	<u>75</u>	<u>110</u>
<u>0</u> miles <u>South</u> of <u>Caesar</u>	<u>Blue Clay</u>	<u>110</u>	<u>190</u>
(distance) (direction) (nearest town)	<u>Fine Sand</u>	<u>190</u>	<u>202</u>
WELL PURPOSE: <u>Farm</u> (home, irrigation, municipal, industrial)	<u>Blue Clay</u>	<u>202</u>	<u>318</u>
WELL COMPLETION DATA: <u>6 1/2 Drilled</u>	<u>Grey Sand</u>	<u>318</u>	<u>360</u>
(1) diameter (inches) <u>4" x 2"</u>	<u>Blue Clay</u>	<u>360</u>	<u>410</u>
(2) total depth (feet) <u>490</u>	<u>Grey Sand</u>	<u>410</u>	<u>490</u>
(3) static water level (feet) <u>65</u> below top of ground.			
(4) casing <u>Galv</u> , <u>470</u> , (material) (depth)			
<u>4 x 2</u> (size) If telescope see back.			
(5) screen <u>20'</u> , <u>470</u> (length) (depth to top)			
<u>.015 2"</u> , <u>S. Steel</u> (size) (material)			
(6) pump <u>1/2 sub</u> , <u>35</u> (HP) (yield gpm)			
<u>Elec</u> (type power)			
(7) electric log <u>No</u> (yes or no)			
(organization running log)			
(8) how well bottom plugged <u>BW Valve</u>			
DRILLERS REMARKS:			


CODED

DEC 20 1968

MISS. BD. OF  
WATER COM.

If well telescopes please sketch and show depths.

GROUND LEVEL

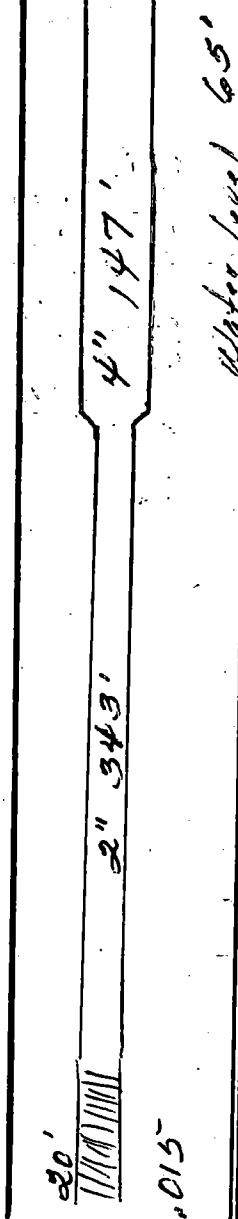

	X		

SECTION 30

Please indicate well location X.

ADDITIONAL INFORMATION

Handwritten notes in the additional information section:

147' x 343'

20' x 2015'

If more than one screen, show locations of each on sketch.