

Hancock
A 7
8-21-69

MISSISSIPPI
 BOARD OF WATER COMMISSIONERS
 416 North State Street
 Jackson, Mississippi 39201

CODED

WATER WELL DRILLERS LOG

8-21 1969 Penlon Well Serv Hancock
 date well completed firm name county well located

LANDOWNER: Leamar Jones
Rt. 2 Box 262
Carriere Miss-
 (mailing address)

description of formations encountered	from	to
Red Clay	0	28
" Sand	28	60
White clay	60	78
Blue clay	78	160
Grey sand	160	183

WELL LOCATION:
 sec. 18 T. 5 S. R. 15 W.
2 miles North of Caesar
 (distance) (direction) (nearest town)

WELL PURPOSE: Home
 (home, irrigation, municipal, industrial)

- WELL COMPLETION DATA:
- (1) diameter (inches) 2"
 - (2) total depth (feet) 183
 - (3) static water level (feet) 60 below ~~above~~ top of ground.
 - (4) casing Galv, 178,
 (material) (depth)
2" If telescope see back.
 (size)
 - (5) screen 5', 178
 (length) (depth to top)
 - (6) pump 1, 10
 (HP) (yield gpm)
Elec
 (type power)
 - (7) electric log NO
 (yes or no)
 - (organization running log)
 - (8) how well bottom plugged B.W. Valve


DRILLERS REMARKS:

.012

8-21-69

If well telescopes please sketch and show depths.

GROUND LEVEL

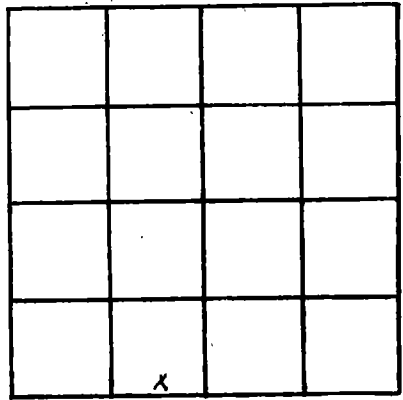

SECTION 18

Please indicate well location X.

ADDITIONAL INFORMATION

If more than one screen, show locations of each on sketch.