

HANCOCK
 A 9
 11-5-69

MISSISSIPPI
 BOARD OF WATER COMMISSIONERS
 416 North State Street
 Jackson, Mississippi 39201

CODED

WATER WELL DRILLERS LOG

11-5 1969 Penton Well Serv Hancock
 date well completed firm name county well located

LANDOWNER: J T Lee
Rt. 3 Box 213
Picayune Miss
 (mailing address)

description of formations encountered	from	to
Red Clay	0	26
" Sand	26	55
White Clay	55	72
Blue Clay	72	255
Grey Sand	255	267
Blue Clay	267	360
Corey Sand	360	405

WELL LOCATION:
 sec. 32 T 5 S R. 15 W
5 miles East of Cesar
 (distance) (direction) (nearest town)

WELL PURPOSE: Home
 (home, irrigation, municipal, industrial)

- WELL COMPLETION DATA:
- (1) diameter (inches) 2
 - (2) total depth (feet) 405
 - (3) static water level (feet) 71 below top of ground.
 - (4) casing Galv (material), 395 (depth)
2" (size) If telescope see back.
 - (5) screen 10 (length), 395 (depth to top)
2" (size), 5. Steel (material)
 - (6) pump 1 (HP), 9 (yield gpm)
Elec (type power)
 - (7) electric log NO (yes or no)
 - (organization running log)
 - (8) how well bottom plugged B.W. Valve


NOV 23 1969

DRILLERS REMARKS:

MISS. Bd. OF
 WATER COMM.

If well telescopes please sketch and show depths.

GROUND LEVEL

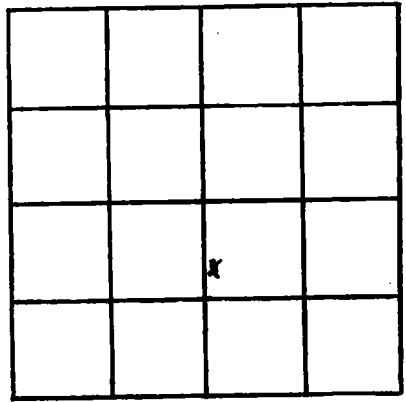

SECTION 32

Please indicate well location X.

ADDITIONAL INFORMATION

If more than one screen, show locations of each on sketch.