

Hancock  
A 11  
2-10-70

MISSISSIPPI  
BOARD OF WATER COMMISSIONERS  
416 North State Street  
Jackson, Mississippi 39201

**CODED**

WATER WELL DRILLERS LOG

2-10 1970 Penton Well Serv Hancock  
date well completed firm name county well located

LANDOWNER: H. C. Lee  
Rt. 3 Box 238  
Picayune Miss  
(mailing address)

description of formations encountered	from	to
Red Clay	0	18
" Sand	18	82
White Clay	82	115
Blue Clay	115	180
Fine Sand	180	195
Blue Clay	195	328
Grey Sand	328	403

WELL LOCATION:  
sec. 32 T 5 S R 15 W  
4 miles East of Caesar  
(distance) (direction) (nearest town)

WELL PURPOSE: Home  
(home, irrigation, municipal, industrial)

WELL COMPLETION DATA: 4 1/2

(1) diameter (inches) 2"

(2) total depth (feet) 403

(3) static water level (feet) 68 below top of ground

(4) casing Galv, 398, (material) (depth)  
2" (size) If telescope see back.

(5) screen 5', 398 (length) (depth to top)  
2", S. Steel (size) (material)

(6) pump 1 (HP) 10 (yield gpm)  
Elec (type power)

(7) electric log No (yes or no)

(organization running log)

(8) how well bottom plugged BW Valve


DRILLERS REMARKS:

FEB 25 1970

MISS. BD. OF WATER COMM.

If well telescopes please sketch and show depths.

GROUND LEVEL

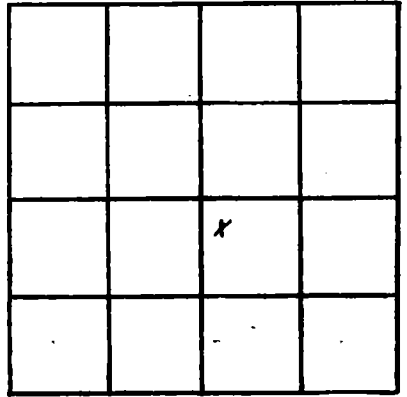

SECTION 32

Please indicate well location X.

ADDITIONAL INFORMATION

If more than one screen, show locations of each on sketch.