

Hancock
A 12
3-19-70

MISSISSIPPI
BOARD OF WATER COMMISSIONERS
416 North State Street
Jackson, Mississippi 39201

WATER WELL DRILLERS LOG
NEIL LUMPKIN WELL DRILLING SERVICE

P. O. BOX 117

CARRIERS, MISS.
firm name

CODED

3-19-70
date well completed

Hancock
county well located

LANDOWNER: Clyde Brooke
1550 2nd St.
New Orleans, La.
(mailing address)

description of formations encountered

from to

WELL LOCATION:
sec. 26 T. 5 R. 15
15 miles East of Carrriere
(distance) (direction) (nearest town)

surface clay	0	15
v sand (no good)	15	40
Blue clay	40	190
sand, fine to better	190	258

WELL PURPOSE: home
(home, irrigation, municipal, industrial)

WELL COMPLETION DATA:

- diameter (inches) 2
- total depth (feet) 258
- static water level (feet) 41 below top of ground
- casing galv. (material) (depth)
24 if telescope see back. (size)
- screen 5' (length) (depth to top)
2" (size) St. Steel (material)
- pump 3/4 (HP) (yield gpm)
electric (type power)
- electric log No. (yes or no)

(organization running log)

(8) how well bottom plugged Johnson back pressure valve


DRILLERS REMARKS:

MISS. BD. OF
WATER COM.

3 1970

If well telescopes please sketch and show depths.

GROUND LEVEL

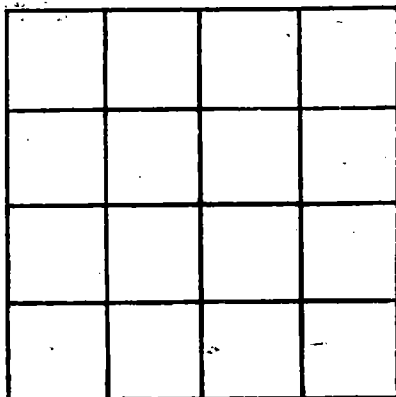

SECTION _____

Please indicate well location X.

ADDITIONAL INFORMATION

If more than one screen, show locations of each on sketch.