

Hancock
A 14
4-11-70

MISSISSIPPI
BOARD OF WATER COMMISSIONERS
416 North State Street
Jackson, Mississippi 39201

CODED

WATER WELL DRILLERS LOG

4-11-70 date well completed 1970 Penton Well Serv firm name Hancock county well located

LANDOWNER: Norman Stocksbury
Rt. 3 Box 284
Picayune MISS
(mailing address)

Description of formations encountered	from	to
Red clay	0	20
" Sand	20	45
White Clay	45	68
Blue Clay	68	190
Silt	190	208
Blue Clay	208	295
Grey Sand	295	342

WELL LOCATION:
sec. 33 T. 5 R. 15
3 1/2 miles East of Crescent
(distance) (direction) (nearest town)

WELL PURPOSE: Home
(home, irrigation, municipal, industrial)

- WELL COMPLETION DATA:
- (1) diameter (inches) 2
 - (2) total depth (feet) 342
 - (3) static water level (feet) 34 below top of ground
 - (4) casing Galv. 337
(material) (depth)
2 If telescope see back.
(size)
 - (5) screen 5 337
(length) (depth to top)
2" S. Steel
(size) (material)
 - (6) pump 1/2 12
(HP) (yield gpm)
Elec
(type power)
 - (7) electric log No
(yes or no)
 - (organization running log)
 - (8) how well bottom plugged B.W. Valve


DRILLERS REMARKS:

MAY 5 1970

MISS. BD. OF
WATER COMM.

If well telescopes please sketch and show depths.

GROUND LEVEL

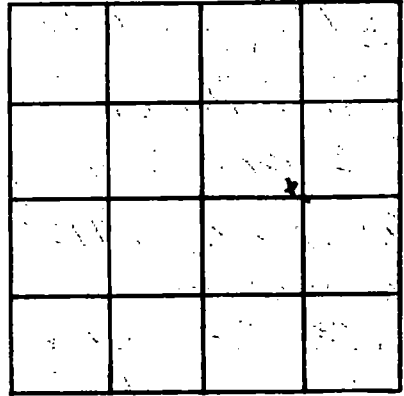

SECTION 33

Please indicate well location X.

ADDITIONAL INFORMATION

If more than one screen, show locations of each on sketch.