

MISSISSIPPI  
 BOARD OF WATER COMMISSIONERS  
 416 North State Street  
 Jackson, Mississippi 39201

**CODED**

WATER WELL DRILLERS LOG

Hancock  
A 15  
4-14-70

4-14- 1970 Peaton Well Serv Hancock  
 date well completed firm name county well located

LANDOWNER: Edward Dobson  
Rt. 2 Box 266  
Carriere Miss  
 (mailing address)

| description of formations encountered | from | to  |
|---------------------------------------|------|-----|
| Surface Clay                          | 0    | 22  |
| Red Sand                              | 22   | 42  |
| White Clay                            | 42   | 55  |
| Blue Clay                             | 55   | 180 |
| Fine Sand                             | 180  | 215 |
| Grey Sand                             | 215  | 237 |

WELL LOCATION:  
 sec. 7 T. 5 R. 15  
3 miles North of Cesar  
 (distance) (direction) (nearest town)

WELL PURPOSE: Home  
 (home, irrigation, municipal, industrial)

- WELL COMPLETION DATA:
- (1) diameter (inches) 2
  - (2) total depth (feet) 237
  - (3) static water level (feet) 46 <sup>Calc.</sup> below top of ground.
  - (4) casing 2 (material) 232 (depth)
  - 2 (size) if telescope see back.
  - (5) screen 5' (length) 232 (depth to top)
  - 2 (size) S. Steel (material)
  - (6) pump 1 (HP) 15 (yield gpm)
  - Elec (type power)
  - (7) electric log No (yes or no)
  - (organization running log)
  - (8) how well bottom plugged B.W. Valve


DRILLERS REMARKS:

MAY 1970

MISS  
 WAT

If well telescopes please sketch and show depths.

GROUND LEVEL

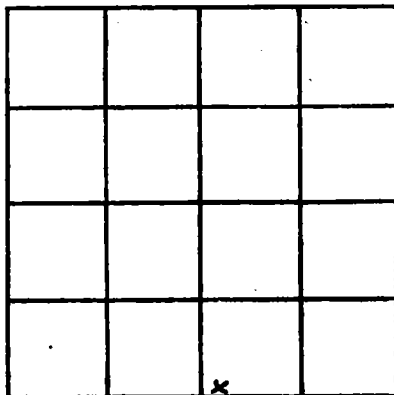

SECTION 7

Please Indicate well location X.

ADDITIONAL INFORMATION

If more than one screen, show locations of each on sketch.