

Hancock
A 17
3-24-70

MISSISSIPPI
BOARD OF WATER COMMISSIONERS
416 North State Street
Jackson, Mississippi 39201

CODED

WATER WELL DRILLERS LOG

3-24 1970 Pendon Well Serv Hancock
date well completed firm name county well located

LANDOWNER: Olis Stackstill
Rt 3 Box 208
Picayune MISS
(mailing address)

description of formations encountered	from	to
	Red clay	0
Red sand	20	90
White clay	90	110
Blue clay	110	318
Grey sand	318	365

WELL LOCATION:
sec. 29 T. 5 R. 15
2 miles East of Caesar
(distance) (direction) (nearest town)

WELL PURPOSE: Home
(home, irrigation, municipal, industrial)

WELL COMPLETION DATA: 4 1/2

(1) diameter (inches) 2"

(2) total depth (feet) 365

(3) static water level (feet) 45 below above top of ground.

(4) casing Galv, 360,
(material) (depth)
2' if telescope see back.
(size)

(5) screen 5', 360
(length) (depth to top)

012 2", S. steel
(size) (material)

(6) pump 3/4 10
(HP) (yield gpm)

Eloc
(type power)

(7) electric log NO
(yes or no)

(organization running log)

(8) how well bottom plugged B.W. Value


MAY 5 1970

MISS. BD. OF
WATER COMM.

DRILLERS REMARKS:

If well telescopes please sketch and show depths.

GROUND LEVEL

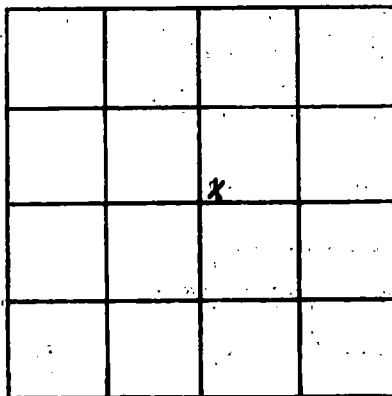

SECTION 29

Please indicate well location X.

ADDITIONAL INFORMATION

If more than one screen, show locations of each on sketch.