

HANCOCK
A 18
7-16-70

MISSISSIPPI
BOARD OF WATER COMMISSIONERS
416 North State Street
Jackson, Mississippi 39201

CODED

WATER WELL DRILLERS LOG

7-16 1970 Penton Well Serv Hancock
date well completed firm name county well located

LANDOWNER: Earl Ted Ford
Rt. 3 Box 289
Picayune Miss
(mailing address)

description of formations encountered	from	to
Surface Clay	0	23
Sand & Gravel	23	35
White Clay	35	55
Blue Clay	55	165
Mud	165	177
Blue Clay	177	190
Sand	190	195
Blue Clay	195	300
Corey sand	300	362

WELL LOCATION:
sec. 33 T 5 S R 15 E W
5 miles East of Caesar
(distance) (direction) (nearest town)

WELL PURPOSE: HOME
(home, irrigation, municipal, industrial)

WELL COMPLETION DATA:

(1) diameter (inches) 2

(2) total depth (feet) 362

(3) static water level (feet) 48 below above top of ground.

(4) casing Galv (material), (depth),
2 (size) If telescope see back.

(5) screen 5 (length), 357 (depth to top)
2 (size), S. steel (material)

(6) pump 1 (HP), 11 (yield gpm)
Elec (type power)

(7) electric log NO (yes or no)
(organization running log)

(8) how well bottom plugged B.W. Value


CODED

AUG 10 1970

DRILLERS REMARKS:

If well telescopes please sketch and show depths.

GROUND LEVEL

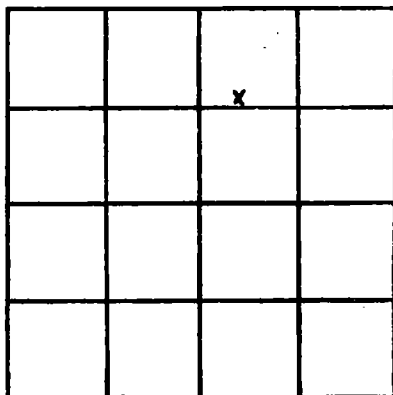

SECTION 33

Please indicate well location X.

ADDITIONAL INFORMATION

If more than one screen, show locations of each on sketch.