

HANCOCK
A27
2-21-72

MISSISSIPPI
 BOARD OF WATER COMMISSIONERS
 416 North State Street
 Jackson, Mississippi 39201

CODED

1972

WATER WELL DRILLERS LOG


2-21-1972 *Neil Lumpkin Well Hancock*
 date well completed *Drilled Service* Drilling name county well located

LANDOWNER: <i>M. J. Pippin</i> <i>Picayune, Miss.</i> <i>Route</i> <small>(mailing address)</small>	description of formations encountered	from	to
WELL LOCATION: sec. <i>29</i> T. <i>5</i> R. <i>15</i> <i>8</i> miles <i>East</i> <i>Picayune</i> <small>(distance) (direction) of (nearest town)</small>	<i>Surface clay</i>	<i>0</i>	<i>20</i>
WELL PURPOSE: <i>home</i> <small>(home, irrigation, municipal, industrial)</small>	<i>sand</i>	<i>20</i>	<i>80</i>
WELL COMPLETION DATA: (1) diameter (inches) <i>2"</i>	<i>Blue clay</i>	<i>80</i>	<i>130</i>
(2) total depth (feet) <i>165</i>	<i>Good sand</i>	<i>130</i>	<i>165</i>
(3) static water level (feet) <i>20</i> <small>below above top of ground.</small>			
(4) casing <i>galv.</i> <small>(material) (depth)</small> <i>2"</i> <small>(size) If telescope see back.</small>			
(5) screen <i>5'</i> <small>(length) (depth to top)</small> <i>2"</i> <i>S. Steel</i> <small>(size) (material)</small>			
(6) pump <i>3/4</i> <i>450 gph</i> <small>(HP) (yield gpm)</small> <i>His pumps electric</i> <small>(type power)</small>			
(7) electric log <i>No.</i> <small>(yes or no)</small>			
<small>(organization running log)</small>			
(8) how well bottom plugged <i>Johnson</i> <i>BP Valve</i>			
DRILLERS REMARKS:			

CODED

If well telescopes please sketch and show depths.

GROUND LEVEL

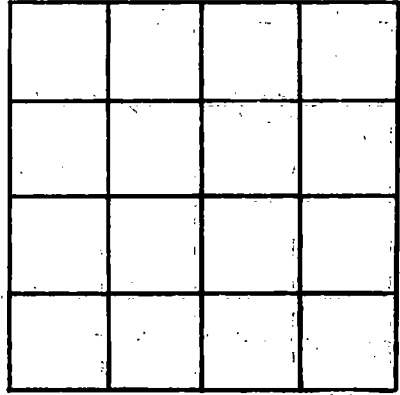

SECTION _____

Please indicate well location X.

ADDITIONAL INFORMATION

If more than one screen, show locations of each on sketch.