

HANCOCK
A 28
6-9-72

MISSISSIPPI
 BOARD OF WATER COMMISSIONERS
 416 North State Street
 Jackson, Mississippi 39201

WATER WELL DRILLERS LOG

CODED

6-9 date well completed 72 Ponton Well Serv firm name Hancock county well located

LANDOWNER: R. L. Lowe
Rt. 3
Picayune MISS
 (mailing address)

WELL LOCATION:
 sec. 29 T. 5 S. R. 15 W.
2 miles East of Caesar
 (distance) (direction) (nearest town)

WELL PURPOSE: Home
 (home, irrigation, municipal, industrial)

WELL COMPLETION DATA: 4 1/2

(1) diameter (inches) 2

(2) total depth (feet) 386

(3) static water level (feet) 71 below ~~above~~ top of ground.

(4) casing Galv. 376
 (material) (depth)

2 if telescope see back.
 (size)

(5) screen 10 376
 (length) (depth to top)

2 S. Steel
 (size) (material)

(6) pump 1 7
 (HP) (yield gpm)

Elec
 (type power)

(7) electric log no
 (yes or no)

(organization running log)

description of formations encountered	from	to
Surface clay	0	36
Red sand	36	72
White clay	72	110
Blue clay	110	325
Sand	325	386

CODED

(8) how well bottom plugged Bl. Galv.

DRILLERS REMARKS:

MISS. STATE WATER

MISS. WATER


If well telescopes please sketch and show depths.

COPIED

GROUND LEVEL

COPIED

If more than one screen, show locations of each on sketch.

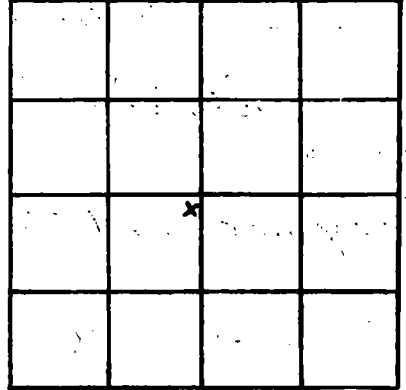

SECTION 29

Please indicate well location X.

ADDITIONAL INFORMATION

Lined area for additional information.