

HANCOCK
A 29
10-14-72

MISSISSIPPI
 BOARD OF WATER COMMISSIONERS
 416 North State Street
 Jackson, Mississippi 39201

WATER WELL DRILLERS LOG

10-14 1972 Ponten Well Serv Hancock
 date well completed firm name county well located

LANDOWNER: Rayford Smith
Rt. 3
Picayune Miss.
 (mailing address)

description of formations encountered	from	to
Surface clay	0	20
Red Sand	20	35
White Clay	35	60
Blue Clay	60	300
Sand	300	346

WELL LOCATION:
 sec. 28 T 5 S R 15 W
3 miles East of Coasar
 (distance) (direction) (nearest town)

WELL PURPOSE: Home
 (home, irrigation, municipal, industrial)

- WELL COMPLETION DATA:
- (1) diameter (inches) 2
 - (2) total depth (feet) 346
 - (3) static water level (feet) 37 below above top of ground.
 - (4) casing Galv, 336,
 (material) (depth)
 - 2
 (size) If telescope see back.
 - (5) screen 10', 336
 (length) (depth to top)
 - 2, S. Steel
 (size) (material)
 - (6) pump 1/2 (HP) (yield gpm)
Elec
 (type power)
 - (7) electric log NO
 (yes or no)

(organization running log)


(8) how well bottom plugged BW Valve

NOV 15 1972

DRILLERS REMARKS: _____

If well telescopes please sketch and show depths.

GROUND LEVEL

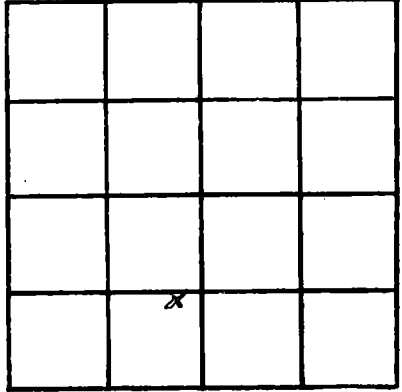

SECTION 28

Please indicate well location X.

ADDITIONAL INFORMATION

If more than one screen, show locations of each on sketch.