

HANCOCK
A 30
10-21-72

MISSISSIPPI
 BOARD OF WATER COMMISSIONERS
 416 North State Street
 Jackson, Mississippi 39201

WATER WELL DRILLERS LOG

10-21 1972 Penton Well Serv HANCOCK
 date well completed firm name county well located

LANDOWNER: R. Flint
Rt. 3
Picayune Miss
 (mailing address)

description of formations encountered	from	to
Surface Clay	0	32
Sand	32	75
White Clay	75	93
Blue Clay	93	190
Sand	190	229

WELL LOCATION:
 sec. 26 T. 5 N. R. 15 W.
5 miles East of Caesar
 (distance) (direction) (nearest town)

WELL PURPOSE: Home
 (home, irrigation, municipal, industrial)

WELL COMPLETION DATA:

(1) diameter (inches) 2

(2) total depth (feet) 229

(3) static water level (feet) 87 below top of ground.

(4) casing Galv. 219
 (material) (depth)

2 If telescope see back.
 (size)

(5) screen 10' 219
 (length) (depth to top)

2 S. Steel
 (size) (material)

(6) pump 1
 (HP) (yield gpm)

Eloc
 (type power)

(7) electric log NO
 (yes or no)

(organization running log)


(8) how well bottom plugged BW Valve

DRILLERS REMARKS:

NOV 15 1972

If well telescopes please sketch and show depths.

GROUND LEVEL

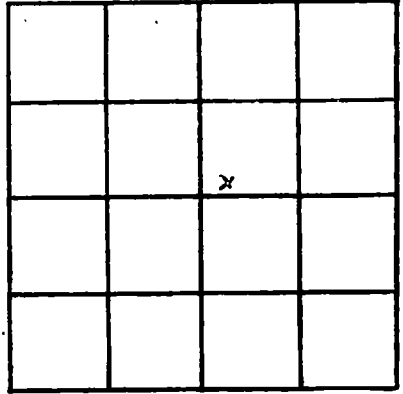

SECTION 26

Please indicate well location X.

ADDITIONAL INFORMATION

If more than one screen, show locations of each on sketch.