

MISSISSIPPI  
BOARD OF WATER COMMISSIONERS  
416 North State Street  
Jackson, Mississippi 39201

**CODED**

WATER WELL DRILLERS LOG

HANCOCK  
A 31  
1-9-73

1-9 1973 Penton Well Serv Hancock  
date well completed firm name county well located

LANDOWNER: Don Cooss  
Rt. 3  
Picayune Miss  
(mailing address)

description of formations encountered	from	to
Surface clay	0	30
Red sand	30	90
Blue clay	90	240
Fine sand	240	335
Blue clay	335	360
Sand	360	430

WELL LOCATION:  
sec. 30 T. 5 S. R. 15 W.  
1/2 miles East of Cesar  
(distance) (direction) (nearest town)

WELL PURPOSE: Home  
(home, irrigation, municipal, industrial)


- WELL COMPLETION DATA:
- (1) diameter (inches) 2
  - (2) total depth (feet) 430
  - (3) static water level (feet) 52 below top of ground.
  - (4) casing Galv 420,  
(material) (depth)  
2 If telescope see back.  
(size)
  - (5) screen 10' 420  
(length) (depth to top)  
2 S. Steel  
(size) (material)
  - (6) pump 1 10  
(HP) (yield gpm)  
Elec.  
(type power)
  - (7) electric log NO  
(yes or no)  
  
(organization running log)
  - (8) how well bottom plugged Bad

**CODED**

DRILLERS REMARKS:

If well telescopes please sketch and show depths.

GROUND LEVEL

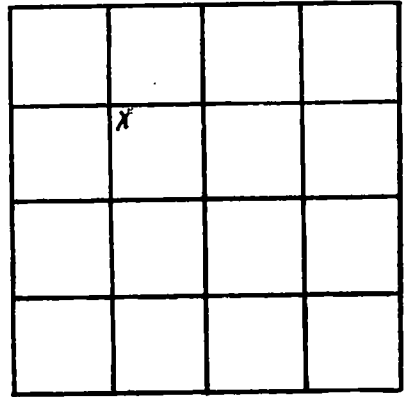

SECTION 30

Please indicate well location X.

ADDITIONAL INFORMATION

If more than one screen, show locations of each on sketch.