

HANCOCK
A34
8-20-74

MISSISSIPPI
BOARD OF WATER COMMISSIONERS
416 North State Street
Jackson, Mississippi 39201

CODED

WATER WELL DRILLERS LOG

8-20 date well completed 1974 Pumpkin Well Ser. firm name Hancock county well located

LANDOWNER:
Mr. A. F. Le Ruth
New Orleans, La.
(mailing address)

description of formations encountered	from	to
Clay	0	20
Sand	20	60
Clay	60	290
Sand	290	350

WELL LOCATION:
sec. 20 T. 5 N. R. 15 E.
11 miles West of Carriere
(distance) (direction) (nearest town)

WELL PURPOSE: Home
(home, irrigation, municipal, industrial)

WELL COMPLETION DATA:

(1) diameter (inches) 2"

(2) total depth (feet) 350

(3) static water level (feet) 65 below top of ground.

(4) casing P.V.C. 345'
(material) (depth)
2" (size) If telescope see back.

(5) screen 5' 345'
(length) (depth to top)
2" P.V.C.
(size) (material)

(6) pump 1 360 gpm
(HP) (yield gpm)
Chee
(type power)


(7) electric log No
(yes or no)

(organization running log)

(8) how well bottom plugged Sand

CODED

DRILLERS REMARKS:

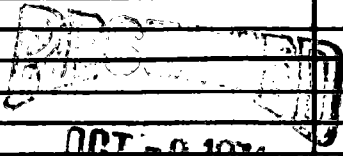

OCT - 9 1974

MISS. BD. OF WATER COM.

If well telescopes: please sketch and show depths.

GROUND LEVEL

SECTION _____

Please indicate well location X.

ADDITIONAL INFORMATION

If more than one screen, show locations of each on sketch.